

WASHINGTON
S 2001
11-12-76

MISSISSIPPI
BOARD OF WATER COMMISSIONERS
416 North State Street
151 Jackson, Mississippi 39201

WATER WELL DRILLERS LOG

12 NOV. 1976 Lambert Drilling Co. Wash
date well completed firm name county well located


LANDOWNER:	description of formations encountered	from	to
Joe Herancey Hollandale, Miss. (mailing address)			
	Sand.	20	60
WELL LOCATION: sec 7 T 14 N R 7 E 32 NE Hampton 25 miles S of Greenville (distance) (direction) (nearest town)	Sand & gravel	60	140
	Clay	140	320
WELL PURPOSE: home (home, irrigation, municipal, industrial)	Clay st Sand.	320	420
WELL COMPLETION DATA:	Sand & fine	420	440
(1) diameter (inches) 2	Sand clay st	440	560
(2) total depth (feet) 795	Sand st Clay	560	735
(3) static water level (feet) 32 below top of ground.	Sand good	735	795
(4) casing steel 785 (material) (depth)			
(size) If telescope see back.			
(5) screen 10 795 (length) (depth to top)			
2 5.5 (size) (material)			
(6) pump 1 10 (HP) (yield gpm)			
elect (type power)			
(7) electric log (yes or no)			
(organization running log)			
(8) how well bottom plugged back wash			
DRILLERS REMARKS:			

RECEIVED
JAN 10 1977

MISS. BU. OF WATER

If well telescopes please sketch and show depths.

GROUND LEVEL

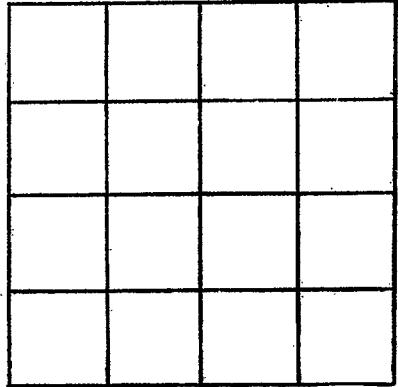

SECTION _____

Please indicate well location X.

ADDITIONAL INFORMATION

If more than one screen, show locations of each on sketch.