

WASHINGTON

5 2002  
5-26-77

MISSISSIPPI  
BOARD OF WATER COMMISSIONERS  
416 North State Street  
Jackson, Mississippi 39201

WATER WELL DRILLERS LOG

5-310  
date well completed

15Z 77 Owens Ploggs/Htg - Wash  
firm name county well located

LANDOWNER: B.F. Carter

description of formations encountered

from to

Men Allen ms.

38744

(mailing address)

top soil

0 26'

WELL LOCATION:

sec 34 T 14 N R 8 E  
2 1/2 miles N/E of Idenalle  
(distance) (direction) (nearest town)

Clay  
Sand & gravel

216 146'  
146 274'

sand

274 500

WELL PURPOSE: Home  
(home, irrigation, municipal, industrial)

WELL COMPLETION DATA:

- (1) diameter (inches) 2"
- (2) total depth (feet) 500'
- (3) static water level (feet) 16' below top of ground.
- (4) casing PVC 480'  
(material) (depth)
- (5) screen 20' 480'  
(length) (depth to top)
- 2" PVC  
(size) (material)
- (6) pump 1 14  
(HP) (yield gpm)
- Elec  
(type power)
- (7) electric log no  
(yes or no)

(organization running log)

(8) how well bottom plugged


DRILLERS REMARKS: Owens

RECEIVED  
JUN 8 1977

MISS. BD. OF WATER COMMISSIONERS

If well telescopes please sketch and show depths.

GROUND LEVEL

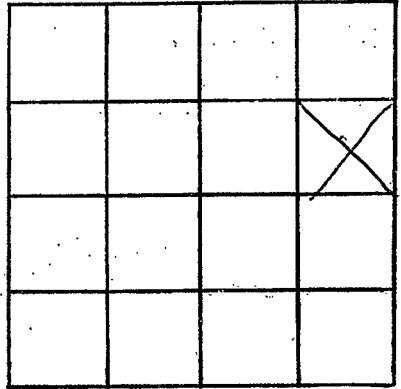

SECTION \_\_\_\_\_

Please indicate well location X.

ADDITIONAL INFORMATION

If more than one screen, show locations of each on sketch.