

WASHINGTON

S 2003

4/18/78

MISSISSIPPI BOARD OF WATER COMMISSIONERS
416 North State Street
Jackson, Mississippi 39201

WATER WELL DRILLERS LOG

4-18 1978
date well completed

1978 Bailey Drilling Co
firm name

Washington
county well located

LANDOWNER: WC McKamey
Ellen Allan, Miss.

(mailing address)

WELL LOCATION:

sec. 16 T 14 N R 8 E
S W
2 miles W of Ellen Allan
(distance) (direction) (nearest town)

WELL PURPOSE: Home
(home, irrigation, municipal, industrial)

WELL COMPLETION DATA:

- (1) diameter (inches) 4 X 2
- (2) total depth (feet) 820
- (3) static water level (feet) 32 below top of ground.
- (4) casing steel 804 (material) (depth)
4 X 2 if telescope see back. (size)
- (5) screen 16" 804 (length) (depth to top)
2" stainless steel (size) (material)
- (6) pump 1/2 25 (HP) (yield gpm)
Elec (type power)
- (7) electric log no (yes or no)

(organization running log)

(8) how well bottom plugged pack pressure valve

DRILLERS REMARKS:

description of formations encountered

from to

Clay	0	20
Sand	20	40
Gravel	40	80
Mud	80	280
Sand	280	420
Mud	420	560
Sand	560	680
Rock	680	681
Sand	681	820


RECEIVED

APR 20 1978

MISS. BD. OF WATER COMMISSIONERS

If well telescopes please sketch and show depths.

GROUND LEVEL

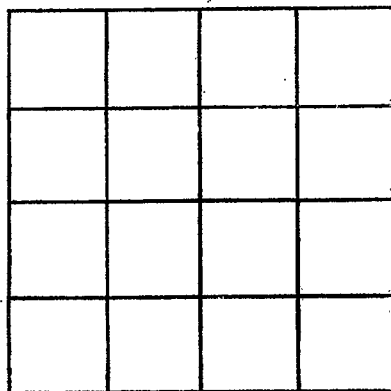

SECTION _____

Please indicate well location X.

ADDITIONAL INFORMATION

If more than one screen, show locations of each on sketch.