

Washington  
 3 2004  
 JUNE 16, 1979

MISSISSIPPI  
 BOARD OF WATER COMMISSIONERS  
 416 North State Street  
 Jackson, Mississippi 39201

WATER WELL DRILLERS LOG

June 16 1979 Owens Plog. Wash.  
 date well completed firm name county well located

LANDOWNER: Albert  
 Law Rt 1, Box 3174  
 Hollandale, ms. 38748  
 (mailing address)

description of formations encountered	from to	
	feet	feet
top soil	0	17'
Sand	17	97
Clay	97	231
Sand + gravel	231	315
Clay	315	363
pk-sand	363	405
Sand	405	660


WELL LOCATION:  
 sec. 2 T 14 N R 8 E  
 6 1/8 miles N of Grenada  
 (distance) (direction) (nearest town)

WELL PURPOSE: home  
 (home, irrigation, municipal, industrial)

WELL COMPLETION DATA:


- (1) diameter (inches) 4" x 2"
- (2) total depth (feet) 660'
- (3) static water level (feet) 19' below top of ground.
- (4) casing PVC 640' (material) (depth)
- (size) If telescope see back.
- (5) screen 20' 660' (length) (depth to top)  
 2" PVC (size) (material)
- (6) pump 1 25 (HP) (yield gpm)  
 Elec. (type power)
- (7) electric log NO (yes or no)
- (organization running log)
- (8) how well bottom plugged S/B

DRILLERS REMARKS:  
 Owens

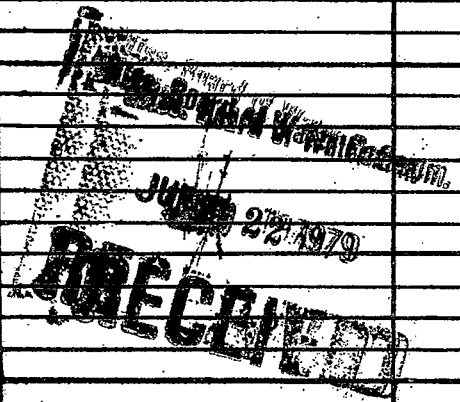

If well telescopes please sketch and show depths.

GROUND LEVEL

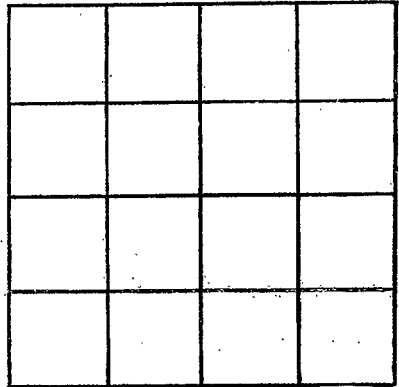

SECTION \_\_\_\_\_

Please indicate well location X.

ADDITIONAL INFORMATION

If more than one screen, show locations of each on sketch.