

MISSISSIPPI DEPARTMENT OF NATURAL RESOURCES

Bureau of Land and Water Resources

Southport Mall

P.O. Box 10631

Jackson, Mississippi 39209

WATER WELL DRILLERS LOG

Washington
S 2005

18 NOV date well completed 1982 Lambert Drilling Co. firm name Wash county well located

LANDOWNER:	description of formations encountered	from	to
<u>Chede Nicholas</u> <u>Glenn Allan</u> (mailing address)			
WELL LOCATION:	<u>sand</u>	<u>10</u>	<u>60</u>
sec <u>33</u> T <u>14</u> N R <u>8</u> E <u>4</u> miles <u>S/E</u> of <u>Glenn Allan</u> (distance) (direction) (nearest town)	<u>sand gravel</u>	<u>60</u>	<u>92</u>
WELL PURPOSE: <u>home</u> (home, irrigation, municipal, industrial)	<u>clay</u>	<u>92</u>	<u>186</u>
WELL COMPLETION DATA:	<u>clay ft sand</u>	<u>186</u>	<u>310</u>
(1) diameter (inches) <u>4x2</u>	<u>sand light</u>	<u>310</u>	<u>380</u>
(2) total depth (feet) <u>452</u>	<u>sand</u>	<u>380</u>	<u>460</u>
(3) static water level (feet) <u>22</u> below above top of ground.			
(4) casing <u>PVC</u> <u>432</u> (material) (depth) <u>4x2</u> if telescope see back. (size)			
(5) screen <u>20</u> <u>432-432</u> (length) (depth to top) <u>2'</u> <u>PVC</u> (size) (material)			
(6) pump <u>1</u> <u>20</u> (HP) (yield gpm) <u>elect</u> (type power)			
(7) electric log <u>no</u> (yes or no)			
(organization running log)			
(8) how well bottom plugged <u>back press.</u>			

DEPT OF NATURAL RESOURCES
BUREAU OF LAND & WATER RESOURCES

DEC - 6 1982

RECEIVED

DRILLERS REMARKS:


If well telescopes please sketch and show depths.

GROUND LEVEL

4" 140

2" 432

2" scr. 452

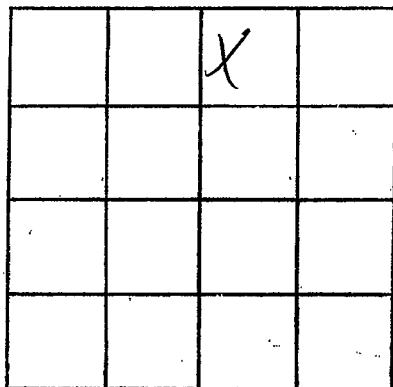

SECTION 83

Please indicate well location X.

ADDITIONAL INFORMATION

If more than one screen, show locations of each on sketch.