

**MISSISSIPPI DEPARTMENT OF NATURAL RESOURCES**  
**Bureau of Land and Water Resources**  
 Southport Mall  
 P.O. Box 10631  
 Jackson, Mississippi 39209  
**WATER WELL DRILLERS LOG**

Washington  
S 2000

7-9 1983 Schultz Drilling Washington  
 date well completed firm name county well located

**LANDOWNER:**  
James Biggs  
Glen Allen  
 (mailing address)

description of formations encountered	from	to
	<u>Clay SAND</u>	<u>0</u> <u>60</u>

**WELL LOCATION:**  
 sec. 32 T. 14 S. R. 7 E. of Glen Allen  
3 miles (distance) E (direction) (nearest town)

**WELL PURPOSE:** IRRIGATION  
 (home, irrigation, municipal, industrial)

- WELL COMPLETION DATA:**
- (1) diameter (inches) 2"
  - (2) total depth (feet) 80'
  - (3) static water level (feet) 19' below/above top of ground.
  - (4) casing PVC, 75' (material), (depth)  
2" (size) if telescope see back.
  - (5) screen 5", 75' (length), (depth to top)  
2" (size), PVC (material)
  - (6) pump Ø (HP), X (yield gpm)  
X (type power)
  - (7) electric log NO (yes or no)  
X (organization running log)
  - (8) how well bottom plugged cap

**DRILLERS REMARKS:**


MISSISSIPPI DEPARTMENT OF NATURAL RESOURCES  
 BUREAU OF LAND AND WATER RESOURCES

AUG 11 1983

**RECEIVED**

If well telescopes please sketch and show depths.

GROUND LEVEL

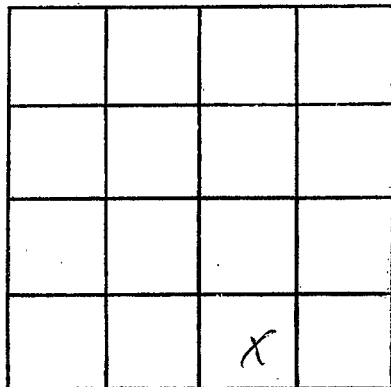

SECTION 32

Please indicate well location X.

ADDITIONAL INFORMATION

If more than one screen,  
show locations of each on sketch.