

MISSISSIPPI DEPARTMENT OF ENVIRONMENTAL QUALITY

Office of Land and Water Resources

P. O. Box 10631
Jackson, MS 39289-0631
WATER WELL DRILLERS LOG

COUNTY WELL LOCATED <u>Washington</u>	
WELL NUMBER <u>S 2015</u>	CODED
DATE WELL COMPLETED <u>4-24-97</u>	

PERMIT NUMBER
NAME OF DRILLING FIRM <u>Schudco Ltd</u>

NAME & MAILING ADDRESS OF LANDOWNER <u>Larry Goss</u> <u>Big River Tract</u> <u>4378 Hwy 1 So.</u> <u>HOLLANDALE MS 38748</u>			
WELL LOCATION:	SEC <u>2</u>	TOWNSHIP <u>14</u>	RANGE <u>N 8 E</u>
DISTANCE <u>6</u> Miles	DIRECTION <u>N</u>	NEAREST TOWN <u>Glen Allen</u>	
OTHER LANDMARK			
WELL PURPOSE: Home, <u>Irrigation</u> , Municipal, Industrial, Fish Pond, etc.			

PUMP DATA		
PUMP TYPE (Circle One): Submersible, <u>Turbine</u> , Jet, Flowing Well, Other (Describe)		
POWER TYPE (Circle One): Electric, Tractor, <u>Diesel</u> , Gasoline, Butane, Other (Describe) H/P <u>80</u>		
Pump Capacity (GPM) <u>600</u>	No. of Stages <u>5</u>	Setting Depth <u>60</u> FT.
PUMP TEST		
Well yielded _____ GPM with a drawdown of _____ ft. after _____ hours of pumping		

WELL DATA		
Well Depth <u>100</u>	Casing Diameter (In.) <u>12</u>	Casing Length (Ft.) <u>80</u>
Type of Casing <u>pvc</u>	Hole Depth <u>100</u>	Depth to Static Water Level <u>18 ft</u>

LOG DATA	
TYPE OF LOG RUN (Circle One): <u>No Log Run</u> Electric, Gamma Ray, Density, Sonic, Neutron, Other (Describe)	
Name of Organization Running Log	

TYPE OF COMPLETION: (Circle One or More):
Gravel Packed, Underreamed, Telescoped,
Natural Development, Open Hole, Other
(Describe)

WELL GROUTED TO A DEPTH OF _____ FEET
Type Grout (circle one): Cement, Bentonite, Mix

GEOLOGIC DATA (Office Use Only)			
Surface Elev.	Geologic Unit	Unit Thickness	Depth to Top-
Subs. SWL	Date	Analysis	Aquifer Test

SCREEN DATA		
Diameter - Inches <u>12</u>	Length - Feet <u>20</u>	Slot Size - Inches <u>.032</u>
Screen Type <u>pvc</u>	Depth to Bottom - Feet <u>100</u>	

Driller's Remarks


DESCRIPTION OF FORMATIONS ENCOUNTERED	FROM	TO
<u>Sandy top soil</u>	<u>0</u>	<u>10</u>
<u>fine sand</u>	<u>10</u>	<u>70</u>
<u>med sand</u>	<u>70</u>	<u>80</u>
<u>Course sand</u>	<u>80</u>	<u>110</u>

FORMATIONS (Continued)	FROM	TO
RECEIVED		
MAY 09 1997		
Dept. of Environmental Quality Office of Land & Water Resources		

IF MORE SPACE IS NEEDED, USE BACK

If well telescopes please sketch and show depths.

GROUND LEVEL

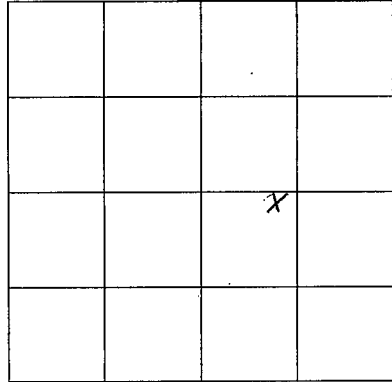

SECTION 14

Please indicate well location X.

ADDITIONAL INFORMATION

If more than one screen,
show location of each on sketch.