

A1

6-12-64

WATER WELL DRILLERS LOG

THIS WELL IS IN CLARKE CO.

Date: June 12, 1964, Driller: Robert Dillingham County Wayne
(Name)

(1) Owner of Land: Arthur Roberts
(Name)
Rt 3 Shubuta, Miss
(Address)

(2) Location: SW 1/4, SW 1/4, Sec. 13 T10R9
3 miles N of Eucutt
(distance) (direction) (Nearest Town)

(3) Topography: Hilly
(Hilly) (Flat) (Level)

(4) Purpose of Well: domestic
(Domestic Irrigation Municipal, Industrial, Other)

Description & Color of Materials Sand, Clay, Red Clay, Shell, etc.	Thick-ness Feet	Depth Feet
red clay	18	18
sand	17	35
sand & shells	25	60
pen gravel	15	75
coarse sand & chalk	7	82
fine sand	4	86
chalk	2	88
course sand	6	94
pen gravel streaks	36	130
fine & course sand		
chalk	2	132

Information upon completion of well:

(1) Diameter 2" inches.

(2) Total Depth 130' feet.

(3) Water Level 112' feet below top of ground.


(4) Cased to 125', Size 2"

(5) Screen: Size 1 1/4", Length 5'
Johnson S.S.

(6) Were any formations sealed against pollution?
 _____ yes, X no.

If YES depth of formation _____
 Why _____

Drillers Remarks: _____

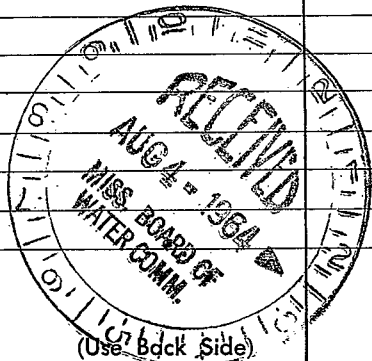

Well No. _____

