

WAYNE MISSISSIPPI BOARD OF WATER COMMISSIONERS

A2
2-28-64

WATER WELL DRILLERS LOG

Date: Feb. 28, 1964, Driller: Porter Drilling & Supply Co. County: Wayne
30 (Name)

(1) Owner of Land: Frank Dwyer
(Name)
At 2 Heidelberg, Miss.
(Address)
(2) Location: NW 1/4, NW 1/4, Sec. 32, T10R9,
3 miles west of Escutla,
(distance) (direction) (Nearest Town)
(3) Topography: hilly
(Hilly) (Flat) (Level)
(4) Purpose of Well: domestic
(Domestic Irrigation
Municipal, Industrial, Other)


Description & Color of Materials Sand, Clay, Red Clay, Shell, etc.	Thick- ness Feet	Depth Feet
clay	8	8
sand & chalk	8	16
yellow chalk	9	25
white chalk	15	40
fine sand & chalk	6	46
chalk	10	56
sand	13	69
stopped while still in sand		

Information upon completion of well:

(1) Diameter 2" inches.
(2) Total Depth 69' feet.
(3) Water Level 56' feet below top of ground.
(4) Cased to 63', Size 2"
(5) Screen: Size 1 1/4", Length 6'
80 ga.
(6) Were any formations sealed against pollution?
yes, X no.

If YES depth of formation:
Why:

Drillers Remarks:

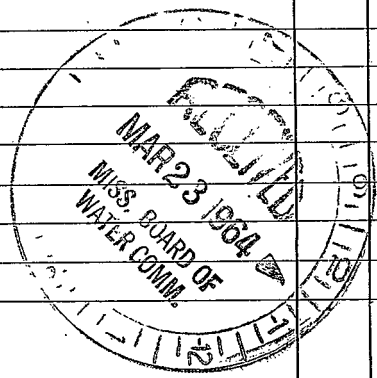

(Use Back Side)

