

A3

5-2-61

WATER WELL DRILLERS LOG

A 300

Date: May 2, 1961, Driller: D. N. Porter Wayne County
(Name)


	Description & Color of Materials Sand, Clay, Red Clay, Shell, etc.	Thick- ness Feet	Depth Feet
(1) Owner of Land: <u>Waskel Logan</u> <small>(Name)</small> <u>At 3 Shubuta Miss</u> <small>(Address)</small>	<u>clay</u>	<u>10</u>	<u>10'</u>
(2) Location: <u>SW 1/4, NE 1/4, Sec 27 T10 R9</u>	<u>blue chert</u>	<u>55</u>	<u>65</u>
<u>1 1/2</u> miles <u>west</u> , of <u>Euclid</u> <small>(distance) (direction) (Nearest Town)</small>	<u>heavy core rock</u> <u>stop in chert</u>	<u>36</u>	<u>101</u>
(3) Topography: <u>hilly</u> <small>(Hilly) (Flat) (Level)</small>			
(4) Purpose of Well: <u>Domestic</u> <small>(Domestic Irrigation Municipal, Industrial, Other)</small>			

Information upon completion of well:

- (1) Diameter 2" inches.
- (2) Total Depth 101 feet.
- (3) Water level 20' feet below top of ground.
- (4) Cased to 65', Size 2"
- (5) Screen: Size none, Length _____
- (6) Were any formations sealed against pollution?
 yes, no.

If YES depth of formation 65'
 Why Cased to hard rock

Drillers Remarks: _____

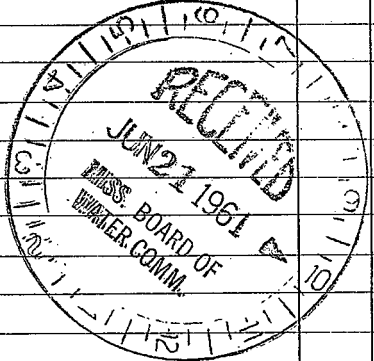

(Use Back Side)

Well No.

