

WAYNE MISSISSIPPI BOARD OF WATER COMMISSIONERS

A4

8-27-62

WATER WELL DRILLERS LOG

3P

Date: Aug 27, 1962, Driller: Porter Drilling & Pump County Wayne
 (Name)

(1) Owner of Land: <u>J. S. Logan</u> <small>(Name)</small>	Description & Color of Materials Sand, Clay, Red Clay, Shell, etc.	Thick- ness Feet	Depth Feet
<u>Box 3 Shubuta, Miss.</u> <small>(Address)</small>	<u>red clay</u>	<u>18</u>	<u>18'</u>
(2) Location: <u>SW 1/4, SE 1/4, Sec. 13 T10R9</u>	<u>chalk & sand</u>	<u>25</u>	<u>43</u>
<u>3</u> miles <u>NE</u> of <u>Escatawpa</u> <small>(distance) (direction) (Nearest Town)</small>	<u>sand</u>	<u>13</u>	<u>56</u>
(3) Topography: <u>Hilly</u> <small>(Hilly) (Flat) (Level)</small>			
(4) Purpose of Well: <u>domestic</u> <small>(Domestic Irrigation Municipal, Industrial, Other)</small>			


Information upon completion of well:

- (1) Diameter 2" inches.
- (2) Total Depth 56' feet.
- (3) Water Level 35' feet below top of ground.
- (4) Cased to 50', Size 2"
- (5) Screen: Size 1 1/4", Length 6'
- (6) Were any formations sealed against pollution?
 yes, no.

If YES depth of formation _____

Why _____

Drillers Remarks: _____

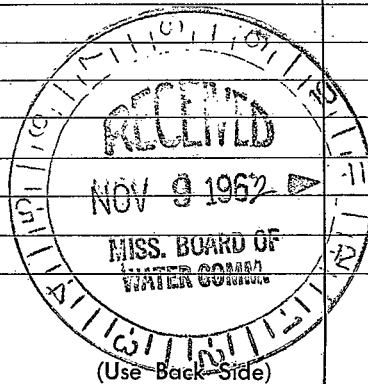

Well No.

