

WAYNE MISSISSIPPI BOARD OF WATER COMMISSIONERS

A5

4-15-65

3P

WATER WELL DRILLERS LOG

Date April 15, 1965, Driller Porter Drilling & Sup. County Wayne
 (Name)

(1) Owner of Land:	Description & Color of Materials Sand, Clay, Red Clay, Shell, etc.	Thick- ness Feet	Depth Feet
<u>Zion's Pent Method</u> (Name)	<u>red clay</u>	<u>8</u>	<u>8</u>
<u>At 3 Shubuta, Miss</u> (Address)	<u>course sand to pea gravel</u>	<u>39</u>	<u>46</u>
(2) Location: <u>NW 1/4, SW 1/4, Sec. 23, T10R9</u>	<u>pea gravel to shells</u>	<u>6</u>	<u>52</u>
<u>13</u> miles <u>NW</u> , of <u>Waynesboro</u> (distance) (direction) (Nearest Town)			
(3) Topography: <u>hilly</u> (Hilly) (Flat) (Level)			
(4) Purpose of Well: <u>domestic</u> (Domestic Irrigation Municipal, Industrial, Other)			


Information upon completion of well:

- (1) Diameter 2" inches.
- (2) Total Depth 46' feet.
- (3) Water Level 33' feet below top of ground.
- (4) Cased to 42', Size 2"
- (5) Screen: Size 2", Length 4'
10 mesh plastic
- (6) Were there any formations sealed against pollution?
 yes, no.

If YES depth of formation _____

Why _____

Drillers Remarks: _____

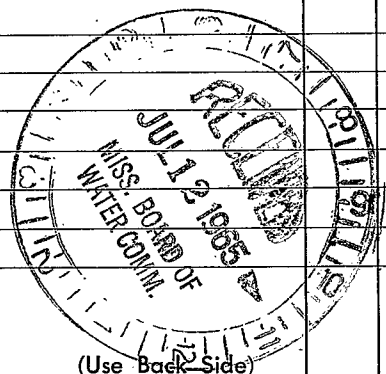

(Use Back Side)

Well No.

