

Wagne

MISSISSIPPI BOARD OF WATER COMMISSIONERS

A6
9-66
3P

WATER WELL DRILLERS LOG

Date: Sept 19, 1966, Driller Porter Drilling Co. County Wayne
(Name)

	Description & Color of Materials Sand, Clay, Red Clay, Shell, etc.	Thick- ness Feet	Depth Feet
(1) Owner of Land: <u>Leslie Lyons</u> (Name) <u>At 3 Shubuta, Miss</u> (Address)	<u>red clay</u>	<u>15</u>	<u>15</u>
(2) Location: <u>SW 1/4, SW 1/4, Sec 13 T.10R 9</u> <u>3</u> miles <u>IVE</u> of <u>Excutter</u> (distance) (direction) (Nearest Town)	<u>red sand</u> <u>sand</u> <u>stopped on chalk</u> <u>cut 8' fine sand</u>	<u>15</u> <u>70</u>	<u>30</u> <u>100</u>
(3) Topography: <u>hilly</u> (Hilly) (Flat) (Level)			
(4) Purpose of Well: <u>domestic</u> (Domestic Irrigation Municipal, Industrial, Other)			


Information upon completion of well:

- (1) Diameter 2" inches.
- (2) Total Depth 95' feet.
- (3) Water Level 82' feet below top of ground.
- (4) Cased to 90', Size 2"
- (5) Screen: Size 1 1/4", Length 5'
6 slot S.S. screwed on casing
- (6) Were any formations sealed against pollution?
yes, X no.

If YES depth of formation _____

Why _____

Drillers Remarks: _____

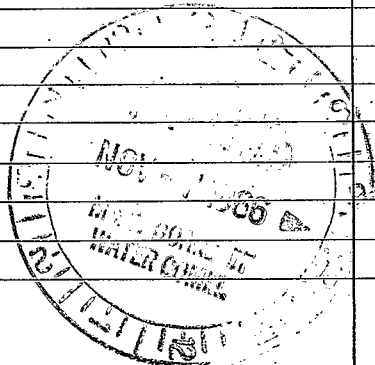

(Use Back Side)

Well No.

