

**MISSISSIPPI
BOARD OF WATER COMMISSIONERS
416 North State Street
Jackson, Mississippi 39201**

WATER WELL DRILLERS LOG

Wayne
A7
12-67
3P

Dec 15 1967 Porter Drilling & Log Wayne
date well completed firm name county well located

LANDOWNER: Burtell Davis
At 1 Shubuta Miss
(mailing address)

WELL LOCATION:
sec 35 T 10 N R 9 E
S W
1 miles S of Enantha
(distance) (direction) (nearest town)

WELL PURPOSE: Home
(home, irrigation, municipal, industrial)

WELL COMPLETION DATA:

(1) diameter (inches) 2"

(2) total depth (feet) 134'

(3) static water level (feet) 62 below above top of ground.

(4) casing steel, 106',
(material) (depth)
2' if telescope see back.
(size)

(5) screen none, _____
(length) (depth to top)
(size) (material)

(6) pump 3/4 _____
(HR) (yield gpm)
elec
(type power)

(7) electric log no
(yes or no)
(organization running log)

(8) how well bottom plugged open

description of formations encountered	from	to
<u>red clay</u>	<u>0</u>	<u>20</u>
<u>clay & sand</u>	<u>20</u>	<u>44</u>
<u>red chalk</u>	<u>44</u>	<u>50</u>
<u>blue chalk</u>	<u>50</u>	<u>60</u>
<u>rock</u>	<u>60</u>	<u>69</u>
<u>blue chalk</u>	<u>69</u>	<u>106</u>
<u>Nickalony honeycomb</u>	<u>106</u>	<u>130</u>
<u>rock</u>	<u>106</u>	<u>130</u>
<u>white chalk</u>	<u>130</u>	<u>134</u>




DRILLERS REMARKS:

If well telescopes please sketch and show depths.

GROUND LEVEL

NE SW

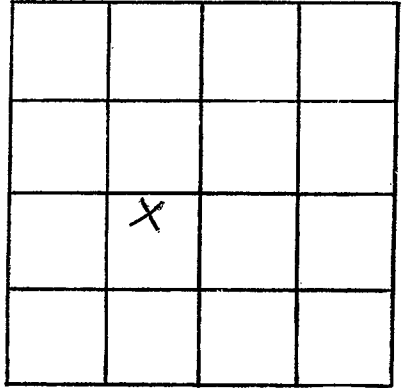

SECTION ~~35~~ 35

Please indicate well location X.

ADDITIONAL INFORMATION

If more than one screen, show locations of each on sketch: