

Wayne
A9
2-68
3P

MISSISSIPPI
BOARD OF WATER COMMISSIONERS
416 North State Street
Jackson, Mississippi 39201

WATER WELL DRILLERS LOG

Feb-20 1968 *Porter Drilling Co* Wayne
date well completed firm name county well located

LANDOWNER: *Thomas Brazier*

description of formations encountered	from	to
<i>red clay</i>	<i>0</i>	<i>25</i>
<i>fine red sand</i>	<i>25</i>	<i>34</i>
<i>coarse red sand</i>	<i>34</i>	<i>41</i>
<i>chals</i>	<i>41</i>	<i>42</i>

Rt 2 Herdellburg Miss
(mailing address)

WELL LOCATION:

sec *21* T-*10* N R-*9* E
S W
2 miles NW of *Encuttla*
(distance) (direction) (nearest town)

WELL PURPOSE: *home*
(home, irrigation, municipal, industrial)

WELL COMPLETION DATA:

- (1) diameter (inches) *2"*
- (2) total depth (feet) *41*
- (3) static water level (feet) *26* below top of ground.
- (4) casing *steel*, *35'*
(material) (depth)
2" if telescope see back.
(size)
- (5) screen *6'*, *35'*
(length) (depth to top)
1/4, *brass jacket*
(size) (material)
- (6) pump *none*, *rob*
(HP) (yield gpm)


(type power)

(7) electric log _____
(yes or no)

(organization running log)

(8) how well bottom plugged
flush screen


DRILLERS REMARKS:

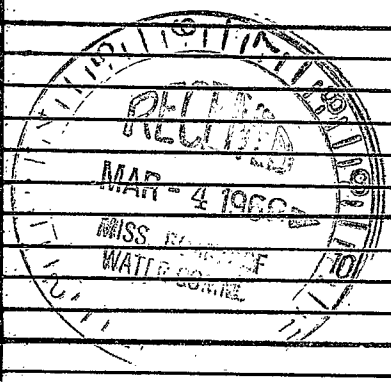

If well telescopes please sketch and show depths.

GROUND LEVEL

N W S E

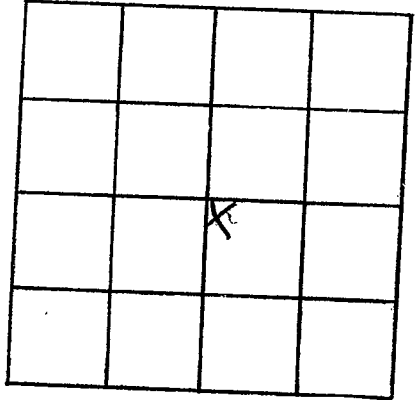

SECTION 21

Please indicate well location X.

ADDITIONAL INFORMATION

If more than one screen,
show locations of each on sketch.