

Wayne  
A 10  
10-13-69

MISSISSIPPI  
BOARD OF WATER COMMISSIONERS  
416 North State Street  
Jackson, Mississippi 39201

CODED

CODED

WATER WELL DRILLERS LOG

10-13-1969 date well completed  
69 Roy U. Westwater Wells firm name  
Wayne county well located

LANDOWNER <i>W. J. Pryor</i> <i>Rt 6 Laurel Miss</i>	description of formations encountered	from	to
		<i>sandy clay</i>	<i>0</i>
	<i>blue clay</i>	<i>35</i>	<i>90</i>
	<i>sand</i>	<i>90</i>	<i>100</i>

(mailing address)

WELL LOCATION:  
sec *33* T *10* N R *9* E  
*15* miles *East* of *Laurel*  
(distance) (direction) (nearest town)

WELL PURPOSE: *home*  
(home, irrigation, municipal, industrial)

- WELL COMPLETION DATA:
- (1) diameter (inches) *2 in*
  - (2) total depth (feet) *100*
  - (3) static water level (feet) *40* <sup>below</sup>/<sub>above</sub> top of ground.
  - (4) casing *galv* *95*  
(material) (depth)
  - (size) *5* *95*  
(5) screen (length) (depth to top)
  - 1 1/2* *st steel*  
(size) (material)
  - (6) pump *1 1/2* *8*  
(HP) (yield gpm)
  - REA*  
(type power)
  - (7) electric log *no*  
(yes or no)
  - (organization running log)
  - (8) how well bottom plugged *wash water*


OCT 15 1969

MISS. BD. OF  
WATER COMM.

DRILLERS REMARKS:

If well telescopes please sketch and show depths.

GROUND LEVEL

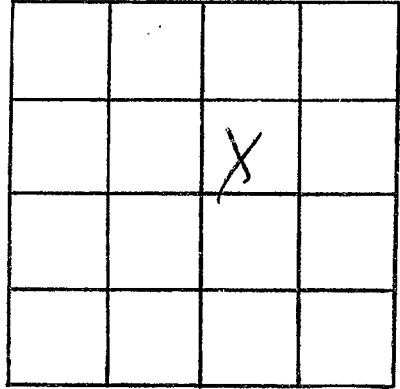

SECTION 33

Please indicate well location X.

ADDITIONAL INFORMATION

If more than one screen, show locations of each on sketch.