

WAYNE
A17
11-17-71

MISSISSIPPI BOARD OF WATER COMMISSIONERS
416 North State Street
Jackson, Mississippi 39201
C. P. CLARK
WATER WELL DRILLING
ROUTE 3
LAUREL, MISS. 39440

WATER WELL DRILLERS LOG

CODED

Wayne


11/17 1971 date well completed
C.P. Clark firm name
Wayne county well located

| LANDOWNER: <u>Will Arrington</u> Rt #1 | description of formations encountered | from | to |
|---|--|------------------------------------|-------------------------------------|
| <u>Shubetta Miss</u> (mailing address) | <u>Sandy Clay</u> <u>Blue Clay</u> <u>Sand</u> | <u>0</u> <u>32</u> <u>71</u> | <u>32</u> <u>71</u> <u>79</u> |
| WELL LOCATION: sec. <u>14</u> T. <u>10N</u> R. <u>9E</u> <u>4</u> miles <u>S</u> of <u>Coletta</u> (distance) (direction) (nearest town) | | | |
| WELL PURPOSE: <u>Home</u> (home, irrigation, municipal, industrial) | | | |
| WELL COMPLETION DATA: | | | |
| (1) diameter (inches) <u>2</u> | | | |
| (2) total depth (feet) <u>79</u> | | | |
| (3) static water level (feet) <u>52</u> below above top of ground. | | | |
| (4) casing <u>Galv. Iron 74</u> (material) (depth) (size) if telescope see back. | | | |
| (5) screen <u>5</u> <u>74</u> (length) (depth to top) <u>1 1/4</u> <u>Solid S.S.</u> (size) (material) | | | |
| (6) pump <u>3/4</u> <u>7</u> (HP) (yield gpm) <u>230V</u> <u>S.P.</u> (type power) | | | |
| (7) electric log <u>NO</u> (yes or no) | | | |
| (organization running log) | | | |
| (8) how well bottom plugged <u>BWU</u> | | | |
| DRILLERS REMARKS: <u>Set 6.3</u> <u>Set 1 1/4</u> <u>Set pipe</u> <u>12 A 9 1/2</u> | | | |

NOV 22 1971
CODED
MISS. BO. OF
WATER COM.

If well telescopes please sketch and show depths.

GROUND LEVEL

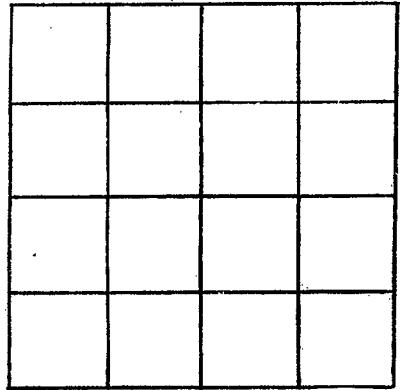

SECTION _____

Please indicate well location X.

ADDITIONAL INFORMATION

If more than one screen,
show locations of each on sketch.