

TMCA

Wayne  
A 18  
2-8-72

CODED

MISSISSIPPI  
BOARD OF WATER COMMISSIONERS  
16 North State Street  
Jackson, Mississippi 39201

MAR 17 1972

WATER WELL DRILLERS LOG

Wayne  
Clout

Feb 8 1972 Roy V Westerdale  
date well completed firm name county well located

LANDOWNER: Tommy Collier  
RT 5  
Shubetta Miss  
(mailing address)

description of formations encountered	from	to
Sandy Clay	0	12
solid	12	45
sandy clay	45	85
solid	85	100

WELL LOCATION:  
sec. 24 T. 10 N. R. 9 E  
12 miles E of Deildburg  
(distance) (direction) (nearest town)

WELL PURPOSE: home  
(home, irrigation, municipal, industrial)


- WELL COMPLETION DATA:
- (1) diameter (inches) 2
  - (2) total depth (feet) 100
  - (3) static water level (feet) 90 below top of ground.
  - (4) casing galv (material), 95 (depth)
  - (size) if telescope see back.
  - (5) screen 5 (length), 95 (depth to top)
  - 1/4 (size), gal stainless (material)
  - (6) pump 1/2 (HP), 42 (yield gpm)
  - Rea (type power)
  - (7) electric log NO (yes or no)
  - (organization running log)
  - (8) how well bottom plugged Washable

CODED

DRILLERS REMARKS:

If well telescopes please sketch and show depths.

GROUND LEVEL

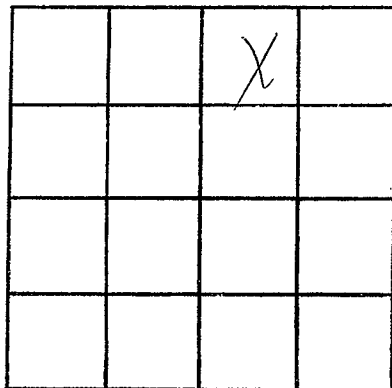

SECTION 24

Please indicate well location X.

ADDITIONAL INFORMATION

If more than one screen,  
show locations of each on sketch.