

BOARD OF WATER COMMISSIONERS

416 North State Street

Jackson, Mississippi 39201

WATER WELL DRILLERS LOG

WAYNE

A 20

10-6-72

Oct 6 1972 date well completed
 Port. Drilling & ~~COOPER~~ firm name
 COOPER county well located

LANDOWNER: John Clovington

description of formations encountered

from to

211 Shubuta Miss
 (mailing address)

Clay	0	2
Chalk	2	30
red sand	30	37
red chalk	37	42
blue chalk	42	57
fine gray sand	57	75
blue chalk	75	87
red	87	94
blue chalk	94	132
Tackaburg	132	155

WELL LOCATION:

sec 35 T 10 N R 9 E
 1 1/2 miles S of Circuttla
 (distance) (direction) (nearest town)

WELL PURPOSE: Home
 (home, irrigation, municipal, industrial)

WELL COMPLETION DATA:

- (1) diameter (inches) 2'
- (2) total depth (feet) 155'
- (3) static water level (feet) 93' below top of ground
- (4) casing steel 132' (material) (depth)
 2' if telescope see back. (size)
- (5) screen none present (length) (depth to top)
 (size) (material)
- (6) pump 1 HP 6 (yield gpm)
 elec (type power)
- (7) electric log (yes or no)
 (organization running log)

105' static depth plugged
 COOPER

(8) how well bottom plugged


DRILLERS REMARKS:

OCT 19 1972

MISSISSIPPI
 WATER BOARD

If well telescopes please sketch and show depths.

GROUND LEVEL

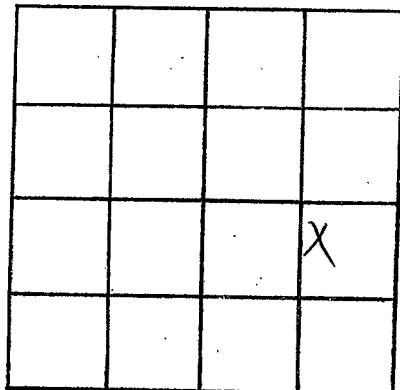

SECTION 35

Please indicate well location X.

ADDITIONAL INFORMATION

If more than one screen,
show locations of each on sketch.