

Wayne
A 21
11-9-72

MISSISSIPPI
BOARD OF WATER COMMISSIONERS
416 North State Street
Jackson, Mississippi 39201

WATER WELL DRILLERS LOG

Nov 9 1972 date well completed
Bohr Drilling & Log firm name
Wayne county well located

LANDOWNER: J. K. Brasher

description of formations encountered	from	to
red clay	0	15
clay & sand	15	38
white chalk	38	41
blue chalk	41	96
Clackburg rock	96	130
63' 1/4" deep pipe		

42 Heidelberg (mailing address)

WELL LOCATION:
sec 21 T 10 N R 9 E
2 miles NW of Encinta (distance) (direction) (nearest town)

WELL PURPOSE: home (home, irrigation, municipal, industrial)

- WELL COMPLETION DATA:
- (1) diameter (inches) 2"
 - (2) total depth (feet) 130'
 - (3) static water level (feet) 41' below top of ground.
 - (4) casing steel 96' (material) (depth)
 - 2" (size) if telescope see back.
 - (5) screen none used (length) (depth to top)
 - (size) (material)
 - (6) pump 1 12 (HP) (yield gpm)
 - elec (type power)
 - (7) electric log no (yes or no)
 - (organization running log)
 - (8) how well bottom plugged open


DRILLERS REMARKS:

NOV 20 1972

MISSISSIPPI
BOARD OF WATER COMMISSIONERS

If well telescopes please sketch and show depths.

GROUND LEVEL

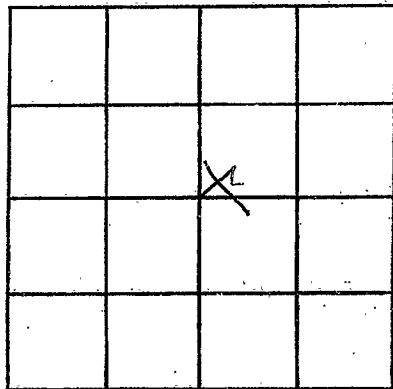

SECTION 21

Please indicate well location X.

ADDITIONAL INFORMATION

If more than one screen, show locations of each on sketch.