

WAYNE  
A 22  
11-5-72

MISSISSIPPI  
 BOARD OF WATER COMMISSIONERS  
 416 North State Street  
 Jackson, Mississippi 39201  
 WATER WELL DRILLERS LOG

**CODED**

11-5-1972 date well completed      JR GREEN WATER WELL firm name      WAYNE county well located

LANDOWNER:  
JOHN BRASHIER  
ROUTE 2 HEIDERBURG MISS.  
 (mailing address)

description of formations encountered	from	to
<u>RED SAND</u>	<u>0</u>	<u>10</u>
<u>" "</u>	<u>10</u>	<u>20</u>
<u>" "</u>	<u>20</u>	<u>30</u>

WELL LOCATION:  
 sec 21 T 10 N R 9 W  
3 miles WEST of EDGEMONT  
 (distance) (direction) (nearest town)

<u>WHITE SAND</u>	<u>30</u>	<u>40</u>
<u>BLUE CHALK</u>	<u>40</u>	

WELL PURPOSE: HOME  
 (home, irrigation, municipal, industrial)

WELL COMPLETION DATA:

(1) diameter (inches) 4

(2) total depth (feet) 40

(3) static water level (feet) 29 below above top of ground.

(4) casing PVC, 35  
 (material) (depth)  
 \_\_\_\_\_ if telescope see back.  
 (size)

(5) screen 5', 35  
 (length) (depth to top)  
2", 008 PVC  
 (size) (material)

(6) pump 1/2  
 (HP) (yield gpm)  
110 V AC  
 (type power)

(7) electric log No  
 (yes or no)  
 \_\_\_\_\_  
 (organization running log)

(8) how well bottom plugged \_\_\_\_\_

**CODED**


DEC 6 1972

DRILLERS REMARKS: Well would not yield enough water for domestic use.

MISSISSIPPI BOARD OF WATER COMMISSIONERS

If well telescopes please sketch and show depths.

GROUND LEVEL

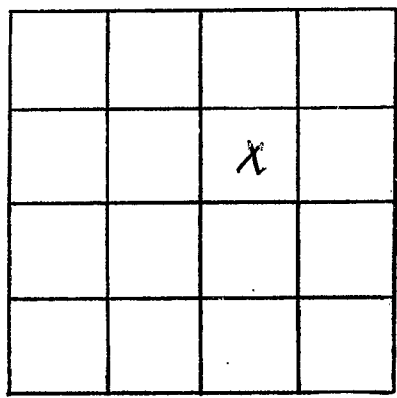

SW  $\frac{1}{4}$  OF NE  $\frac{1}{4}$

SECTION 21

Please indicate well location X.

ADDITIONAL INFORMATION

Lined area for additional information.

If more than one screen, show locations of each on sketch.