

WAYNE  
A 23  
12-11-72

MISSISSIPPI  
BOARD OF WATER COMMISSIONERS  
416 North State Street  
Jackson, Mississippi 39201

**CODED**

WATER WELL DRILLERS LOG

Dec 11 1972 date well completed  
Boor Drilling & Inc firm name  
Wayne county well located

LANDOWNER: Walter Pace  
At 1 Shubuta Miss  
(mailing address)

description of formations encountered	from	to
red clay	0	12
red sand	12	25
red chalk	25	28
blue chalk	28	40
rock strata	40	49
blue chalk	49	88
black shaly rocks	88	121

WELL LOCATION:  
sec. 35 T 10 N R. 9  
1 miles S of Evantta  
(distance) (direction) (nearest town)

WELL PURPOSE: home  
(home, irrigation, municipal, industrial)

WELL COMPLETION DATA:  
(1) diameter (inches) 2"  
(2) total depth (feet) 121  
(3) static water level (feet) 45 below above top of ground.  
(4) casing steel 88'  
(material) (depth)  
2" if telescope see back.  
(size)  
(5) screen none used  
(length) (depth to top)  
(size) (material)  
(6) pump 1 8  
(HP) (yield gpm)  
elec.  
(type power)  
(7) electric log no  
(yes or no)  
(organization running log)  
(8) how well bottom plugged open

63' 1/4" large pipe


**CODED**

DEC 15 1972

DRILLERS REMARKS:

If well telescopes please sketch and show depths.

GROUND LEVEL

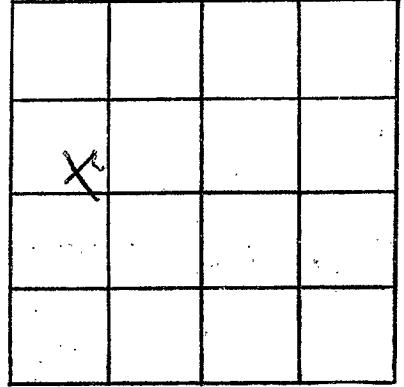

SECTION 35

Please indicate well location X.

ADDITIONAL INFORMATION

If more than one screen,  
show locations of each on sketch.