

**MISSISSIPPI  
BOARD OF WATER COMMISSIONERS**  
416 North State Street  
Jackson, Mississippi 39201

**WAYNE**

**A 24**

**1-30-73**

**WATER WELL DRILLERS LOG**

Jan 30 1973 Rock Drilling & Pump Wayne  
date well completed firm name county well located

LANDOWNER: <u>James H. Brashier</u>	description of formations encountered	from	to
<u>P.O. Box 313 Heidelberg Miss</u> (mailing address)	<u>red clay</u>	<u>0</u>	<u>15</u>
<b>WELL LOCATION:</b> sec <u>23</u> T <u>10</u> N R <u>9</u> E <u>1</u> miles <u>N</u> of <u>Excelsior</u> (distance) (direction) (nearest town)	<u>red clay</u>	<u>15</u>	<u>35</u>
<b>WELL PURPOSE:</b> <u>home</u> (home, irrigation, municipal, industrial)	<u>Chalky sand</u>	<u>35</u>	<u>40</u>
<b>WELL COMPLETION DATA:</b>	<u>weathered chalk</u>	<u>40</u>	<u>48</u>
(1) diameter (inches) <u>2"</u>	<u>sand &amp; yellow chalk</u>	<u>48</u>	<u>59</u>
(2) total depth (feet) <u>151</u>	<u>blue chalk</u>	<u>59</u>	<u>81</u>
(3) static water level (feet) <u>84</u> (below above top of ground)	<u>rock</u>	<u>81</u>	<u>81 1/2</u>
(4) casing <u>steel</u> <u>121'</u> (material) (depth)	<u>blue chalk</u>	<u>81 1/2</u>	<u>121</u>
(5) screen <u>none used</u> (length) (depth to top)	<u>Heidelberg rock</u>	<u>121</u>	<u>151</u>
(6) pump <u>no pump set</u> (HP) (yield gpm)			
(7) electric log <u>no</u> (yes or no)			
(8) how well bottom plugged <u>open</u>			
DRILLERS REMARKS:			


105' 1 1/4' dring pipe

**CODED**

**FEB 20 1973**

If well telescopes please sketch and show depths.

GROUND LEVEL

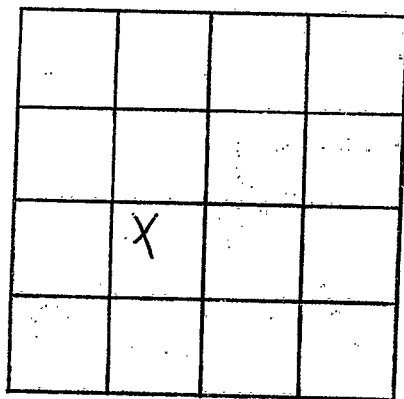

SECTION 23

Please indicate well location X.

ADDITIONAL INFORMATION

If more than one screen,  
show locations of each on sketch.