

WAYNE
A 26
7-14-73

MISSISSIPPI
 BOARD OF WATER COMMISSIONERS
 416 North State Street
 Jackson, Mississippi 39201

CODED

WATER WELL DRILLERS LOG

July 14 1973 Roy West Water Co. Wayne
 date well completed firm name county well located

LANDOWNER: <u>Miss. Collier</u>	description of formations encountered.	from	to
<u>Rt 2 Heidelberg Miss</u>			
(mailing address)	<u>Blue Clay</u>	<u>12</u>	<u>90</u>
	<u>Lime Rock</u>	<u>90</u>	<u>146</u>

WELL LOCATION:
 sec. 28 T. 10 N. R. 9 E
10 miles E of Southern
 (distance) (direction) (nearest town)

WELL PURPOSE: None
 (home, irrigation, municipal, industrial)

- WELL COMPLETION DATA:
- (1) diameter (inches) 2
 - (2) total depth (feet) 140
 - (3) static water level (feet) 45 below above top of ground.
 - (4) casing galv 12.6
 (material) (depth)
 (size) if telescope see back.
 - (5) screen None
 (length) (depth to top)
 (size) (material)
 - (6) pump 1/2 7
 (HP) (yield gpm)
RCA
 (type power)
 - (7) electric log NO
 (yes or no)
 (organization running log)
 - (8) how well bottom plugged westholer


CODED

DRILLERS REMARKS:

AUG 16 1973

If well telescopes please sketch and show depths.

GROUND LEVEL

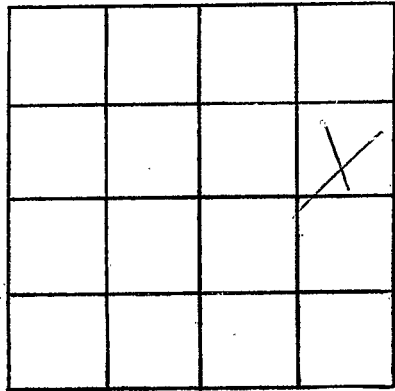

SECTION 28

Please indicate well location X.

ADDITIONAL INFORMATION

If more than one screen,
show locations of each on sketch.