

WAYNE
A 27
8-3-73

MISSISSIPPI
BOARD OF WATER COMMISSIONERS
416 North State Street
Jackson, Mississippi 39201

CODED
USEL 1973

WATER WELL DRILLERS LOG

MISS. BD. OF
WATER COM.

Aug 3 1973
date well completed

Rate Drilling
firm name

Wasp
county well located

LANDOWNER: Walter Huggins

description of formations
encountered

from to

Box 3 Shubuta
(mailing address)

red clay + sand	0	10
blue shale	10	34
red	34	39
blue shale	39	47
red shale	47	62
blue shale	62	68

WELL LOCATION:

sec. 26 T 10 N S R. 9 E W
1/4 miles west of Shubuta
(distance) (direction) (nearest town)

WELL PURPOSE: home
(home, irrigation, municipal, industrial)

WELL COMPLETION DATA:


- (1) diameter (inches) 2'
- (2) total depth (feet) 68'
- (3) static water level (feet) 7' below above top of ground.
- (4) casing steel, 38',
(material) (depth)
2' if telescope see back.
(size)
- (5) screen none used
(length) (depth to top)
(size) (material)
- (6) pump 3/4 10
(HP) (yield gpm)
olac
(type power)
- (7) electric log no
(yes or no)
(organization running log)
- (8) how well bottom plugged open

steel borehole 3 1/2" bucket on end of case
2 1/4" deep pipe
CODED
CODED

DRILLERS REMARKS:

If well telescopes please sketch and show depths.

GROUND LEVEL

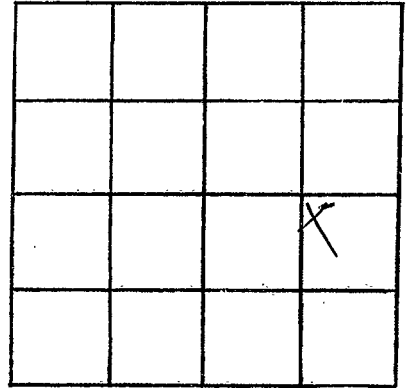

SECTION 26

Please indicate well location X.

ADDITIONAL INFORMATION

If more than one screen, show locations of each on sketch.