

A-29  
 WAYNE Co  
 2-3-84

MISSISSIPPI  
 BOARD OF WATER COMMISSIONERS  
 416 North State Street  
 Jackson, Mississippi 39201

CODED

WATER WELL DRILLERS LOG

TOM GRIFFITH  
 PLUMBING & WELL SERVICE, INC  
 320 WATSON AVE.  
 COLUMBIA, MS 39123

Wayne  
 county well located

2/3  
 date well completed

LANDOWNER: EYLER Drilling Co.  
 P.O. Box 474  
 Laurel, MS. 39440  
 (mailing address)

description of formations encountered	from	to
	Sand + Chalk	0'
BROKEN Lime Stone	80'	240'
Sand	240'	360'

WELL LOCATION:  
 sec. 27 T 100 N R 9 E  
 S W  
 1 miles W of Eucutta  
 (distance) (direction) (nearest town)

CODED

WELL PURPOSE: Oil field location  
 (home, irrigation, municipal, industrial)

- WELL COMPLETION DATA:
- (1) diameter (inches) 3"
  - (2) total depth (feet) 105'
  - (3) static water level (feet) 30 below top of ground.
  - (4) casing TAC 105' (material) (depth)
  - N/A (size) If telescope see back.
  - (5) screen open ended (length) (depth to top)  
 360' of tube (size) (material)
  - (6) pump air 45 (HP) (yield gpm)  
 diesel (type power)
  - (7) electric log N/A (yes or no)  
 N/A (organization running log)
  - (8) how well bottom plugged open

LADD PETROLEUM CORP  
 Nol. John Moore  
 1500' N + 400' W OF SE 1/4 COR  
 SEC 27, 10N 9W

DEPT. OF NATURAL RESOURCES  
 BUREAU OF LAND & WATER RESOURCES


APR 19 1984

DRILLERS REMARKS: new  
 poor well. mixed slats  
 at 360', only 10 gpm

RECEIVED

If well telescopes please sketch and show depths.

GROUND LEVEL

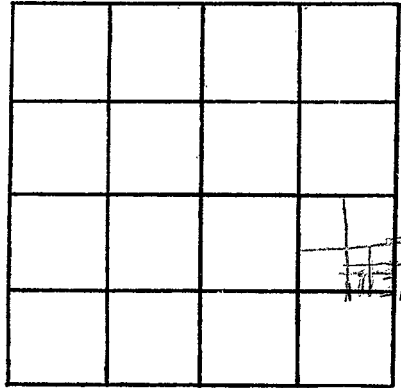

SECTION \_\_\_\_\_

Please indicate well location X.

ADDITIONAL INFORMATION

If more than one screen,  
show locations of each on sketch.