

MISSISSIPPI DEPARTMENT OF NATURAL RESOURCES

Bureau of Land and Water Resources

Southport Mall

P.O. Box 10631

Jackson, Mississippi 39209

WATER WELL DRILLERS LOG

CODED

WAYNE
A 30
8/19/85

8-9

date well completed

1985 Roy K. West Drilling

firm name

Wayne

county well located

LANDOWNER:
Paul Logan
Subuta MS
(mailing address)

description of formations encountered

from

to

SANDY CLAY

0

3

SAND

3

64

GRAVEL

64

85

SAND

85

150

WELL LOCATION:

sec 23 T 10 N R 9 E
S S W
4 miles WW of Eucuttu
(distance) (direction) (nearest town)

CODED

WELL PURPOSE:

(home, irrigation, municipal, industrial)

WELL COMPLETION DATA:

- (1) diameter (inches) 4"
- (2) total depth (feet) 150'
- (3) static water level (feet) 83' below top of ground.
- (4) casing PVC 140' (material) (depth)
(size) if telescope see back.
- (5) screen 10' 140' (length) (depth to top)
4" PVC (size) (material)
- (6) pump 1 (HP) 25 (yield gpm)
DEA (type power)
- (7) electric log no (yes or no)

(organization running log)

- (8) how well bottom plugged WASH VALVE


DRILLERS REMARKS:

RECEIVED
SEP - 9 1985

Department of Natural Resources
Bureau of Land & Water Resource

If well telescopes please
sketch and show depths.

GROUND LEVEL

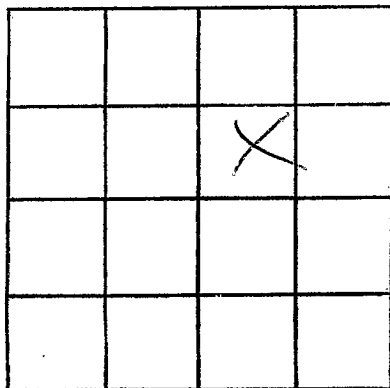

SECTION 23

Please indicate well location X.

ADDITIONAL INFORMATION

If more than one screen,
show locations of each on sketch.