

MISSISSIPPI DEPARTMENT OF NATURAL RESOURCES

Bureau of Land and Water Resources

Southport Mall

P.O. Box 10631

Jackson, Mississippi 39209

WATER WELL DRILLERS LOG

CODED

WAYNE
A 31


9/2/86
date well completed

CARR'S WELL SER.
firm name

WAYNE
county well located

LANDOWNER	description of formations encountered	from	to
ESCUTTA			
BAPTIST CH.			
RT. 1 SHUBUTA, MS. (mailing address)	TOP SOIL	0	1
	RD. CHALK	1	15
	BL. "	15	35
	ROCK STRATORS	35	70
	MOSTLY WH. CHALK	70	78
WELL LOCATION: sec. 26 T. 10 N. R. 9 E IN DOWNTOWN ESCUTTA (distance) miles (direction) of (nearest town)			
WELL PURPOSE: (home, irrigation, municipal, industrial)			
WELL COMPLETION DATA:			
(1) diameter (inches) 2"			
(2) total depth (feet) 78'			
(3) static water level (feet) 21' below top of ground.			
(4) casing P.V.C. 55' (material) (depth) 2" (size) if telescope see back.			
(5) screen OPEN END (length) (depth to top)			
(6) pump 1 (HP) 8 (yield gpm)			
ELEC (type power)			
(7) electric log NO (yes or no)			
(organization running log)			
(8) how well bottom plugged OPEN END			
DRILLERS REMARKS: SHALE TRAP 35'			

CODED

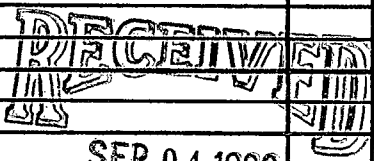

Department of Natural Resources
Bureau of Land & Water Resources

If well telescopes please
sketch and show depths.

300

GROUND LEVEL

SECTION _____

Please indicate well location X.

ADDITIONAL INFORMATION

If more than one screen,
show locations of each on sketch.