

WAYNE
A 2000
1-22-76

MISSISSIPPI
BOARD OF WATER COMMISSIONERS
416 North State Street
13P Jackson, Mississippi 39201

WATER WELL DRILLERS LOG

June 22 1976 Roy West Waterwells Wayne
date well completed firm name county well located

LANDOWNER: <u>Wilmer Morris</u>	description of formations encountered	from	to
<u>RT 2 Box 212 Nield Bay</u> (mailing address)			
	<u>Clay</u>	<u>0</u>	<u>8</u>
	<u>Sandy clay</u>	<u>8</u>	<u>45</u>
	<u>sand</u>	<u>45</u>	<u>65</u>
	<u>Clay</u>	<u>65</u>	<u>150</u>
	<u>lime stone</u>	<u>150</u>	<u>170</u>
WELL LOCATION:			
sec. <u>3B</u> T. <u>10</u> N. R. <u>9</u> E S W			
<u>1</u> miles <u>S</u> of <u>Quetta</u> (distance) (direction) (nearest town)			
WELL PURPOSE: <u>home</u> (home, irrigation, municipal, industrial)			
WELL COMPLETION DATA:			
(1) diameter (inches) <u>2 in</u>			
(2) total depth (feet) <u>170</u>			
(3) static water level (feet) <u>80</u> <u>below</u> above top of ground.			
(4) casing <u>galv</u> <u>147</u> (material) (depth)			
(size) If telescope see back.			
(5) screen <u>0</u> (length) (depth to top)			
(size) (material)			
(6) pump <u>1</u> <u>8</u> (HP) (yield gpm)			
<u>REA</u> (type power)			
(7) electric log <u>NO</u> (yes or no)			
(organization running log)			
(8) how well bottom plugged <u>clay</u>			
DRILLERS REMARKS:			


RECEIVED

JUL 15 1976

MISS. BD. OF WATER COMMISSIONERS

If well telescopes please sketch and show depths.

GROUND LEVEL

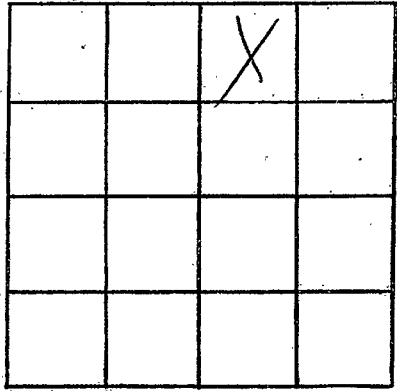

SECTION 33

Please indicate well location X.

ADDITIONAL INFORMATION

If more than one screen,
show locations of each on sketch.