

Wayne
A 2001
3/29/77

MISSISSIPPI
BOARD OF WATER COMMISSIONERS
416 North State Street
Jackson, Mississippi 39201

WATER WELL DRILLERS LOG

March 29 1977 ^{13 P} *Port Drilling* *Wayne*
date well completed firm name county well located

LANDOWNER: *Everette Lane*
Dapt.
At 1 Shubuta Miss
(mailing address)

WELL LOCATION:
sec *26-T-10-N* R *9-E*
miles (distance) (direction) (nearest town) *Everette*

WELL PURPOSE: *drinking water*
(home, irrigation, municipal, industrial)

- WELL COMPLETION DATA:
- (1) diameter (inches) *2"*
 - (2) total depth (feet) *80'*
 - (3) static water level (feet) *15'* below above top of ground.
 - (4) casing *steel* *47'*
(material) (depth)
2" If telescope see back.
(size)
 - (5) screen *not used*
(length) (depth to top)
(size) (material)
 - (6) pump *3/4"* *8*
(HP) (yield gpm)
elec
(type power)
 - (7) electric log *no*
(yes or no)
(organization running log)
 - (8) how well bottom plugged *yes*

DRILLERS REMARKS:


description of formations encountered	depth	
	from	to
<i>red clay</i>	<i>0</i>	<i>12</i>
<i>yellow clay</i>	<i>12</i>	<i>38</i>
<i>rock</i>	<i>38</i>	<i>42</i>
<i>blau</i>	<i>42</i>	<i>46</i>
<i>blue bl. shale</i>	<i>46</i>	<i>75</i>
<i>white clay</i>	<i>75</i>	<i>80</i>
<i>21' 1 1/2" diam pipe</i>	<i>0</i>	<i>80</i>

RECEIVED
APR 6 1977

MISS. BD. OF WATER COMM

If well telescopes please sketch and show depths.

GROUND LEVEL

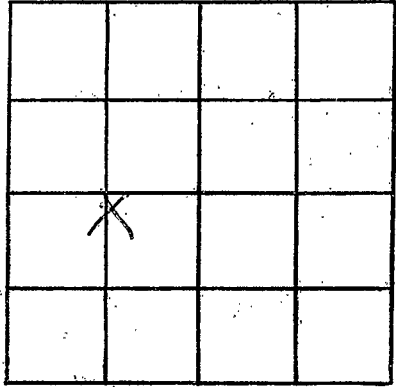

SECTION 26

Please indicate well location X.

ADDITIONAL INFORMATION

If more than one screen,
show locations of each on sketch.