

Wayne
A 2002
10/31/77

MISSISSIPPI
BOARD OF WATER COMMISSIONERS
416 North State Street
Jackson, Mississippi 39201

WATER WELL DRILLERS LOG

Oct 31 1977 Ray West Water Wells Wayne
date well completed firm name county well located


LANDOWNER	description of formations encountered	from	to
Mackey, Louis	red clay	0	8
RFH	clay	8	70
Shubuta Miss (mailing address)	lime rock str	70	100

WELL LOCATION:
sec. 27 T. 10 N. R. 9 E. W. 1
1 miles S of Escatawa
(distance) (direction) (nearest town)

WELL PURPOSE: home
(home, irrigation, municipal, industrial)

- WELL COMPLETION DATA:
- (1) diameter (inches) 4
 - (2) total depth (feet) 100 ft
 - (3) static water level (feet) 20 below top of ground.
 - (4) casing Galv. 80 (material) (depth)
 - (size) If telescope see back.
 - (5) screen 0 (length) (depth to top)
 - (size) (material)
 - (6) pump 1 12 (HP) (yield gpm)
 - REA (type power)
 - (7) electric log No (yes or no)
 - (organization running log)
 - (8) how well bottom plugged Open End

DRILLERS REMARKS:

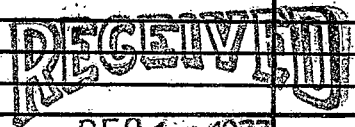

If well telescopes please sketch and show depths.

GROUND LEVEL

			X

SECTION 27

Please indicate well location X.

ADDITIONAL INFORMATION

If more than one screen,
show locations of each on sketch.