

Wayne
A 2003
6-26-79

MISSISSIPPI
 BOARD OF WATER COMMISSIONERS
 416 North State Street
 Jackson, Mississippi 39201

WATER WELL DRILLERS LOG

June 26 1979 Porter Drilling & Log Wayne
 date well completed firm name county well located

LANDOWNER Lynn Pitts
At 1 Shubuta, Miss
 (mailing address)

WELL LOCATION:
 sec. B T. 10 (N) R. 9 (E) S. W
2 miles NE of Quantum
 (distance) (direction) (nearest town)

description of formations encountered	from	to
sand & clay	0	52
clay	52	66
shale	66	90
sand & pea gravel	90	14.5
shel in pea gravel		

WELL PURPOSE: home
 (home, irrigation, municipal, industrial)

135' 1 1/2" galv. drop pipe
2" sand shak & shell trap

WELL COMPLETION DATA:

(1) diameter (inches) 2"

(2) total depth (feet) 143'

(3) static water level (feet) 127 below above top of ground.

(4) casing PVC, 138'
 (material) (depth)
2"
 (size) if telescope see back.

(5) screen 5', 138'
 (length) (depth to top)
2", 8 slot S.S.
 (size) (material)

(6) pump 2 6
 (HP) (yield gpm)
elec
 (type power)

(7) electric log no
 (yes or no)

(organization running log)

(8) how well bottom plugged
2" back wash valve

DRILLERS REMARKS:


Miss. Board of Water Comm.

SEP 10 1979

RECEIVED

If well telescopes please sketch and show depths.

GROUND LEVEL

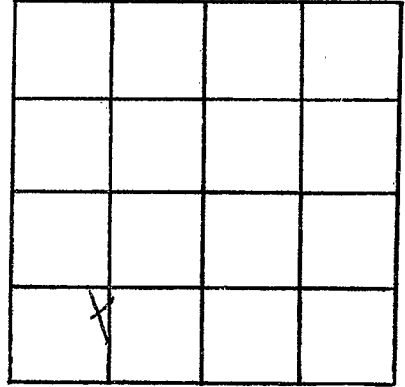

SECTION 13

Please indicate well location X.

ADDITIONAL INFORMATION

If more than one screen, show locations of each on sketch.