

Wayne
Asst
7-5-79
7.5-
 date well completed

MISSISSIPPI
 BOARD OF WATER COMMISSIONERS
 416 North State Street
 Jackson, Mississippi 39201

WATER WELL DRILLERS LOG

1979 Ray Westwater wells Wayne
 firm name county well located

LANDOWNER: Larry Blockley
Rt 2 Box 210
Heidelberg
 (mailing address)

description of formations encountered	from	to
<u>sandy clay</u>	<u>0</u>	<u>15</u>
<u>Blue Clay</u>	<u>15</u>	<u>80</u>
<u>lemon stone</u>	<u>60</u>	<u>130</u>
<u>clay with</u>		
<u>clay</u>	<u>130</u>	<u>150</u>

WELL LOCATION:
 sec. 34 T 10 N R. 9 E
1.6 miles S 7-1/2 of Faunel
 (distance) (direction) (nearest town)

WELL PURPOSE: home
 (home, irrigation, municipal, industrial)

WELL COMPLETION DATA:

(1) diameter (inches) 2

(2) total depth (feet) 150

(3) static water level (feet) 44 below top of ground. above

(4) casing galv 100
 (material) (depth)
 (size) if telescope see back.

(5) screen 0
 (length) (depth to top)
 (size) (material)

(6) pump 1 8
 (HP) (yield gpm)
REA
 (type power)

(7) electric log no
 (yes or no)
 (organization running log)

DEPT. OF NATURAL RESOURCES
 BUREAU OF LAND & WATER RESOURCES

(8) how well bottom plugged Washed


OCT 9 1979

DRILLERS REMARKS:

RECEIVED

If well telescopes please sketch and show depths.

GROUND LEVEL

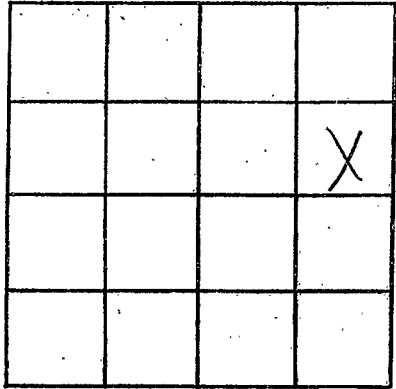

SECTION 34

Please indicate well location X.

ADDITIONAL INFORMATION

If more than one screen, show locations of each on sketch.