

Wayne
A 2005
11-21-79

MISSISSIPPI
BOARD OF WATER COMMISSIONERS
416 North State Street
Jackson, Mississippi 39201

WATER WELL DRILLERS LOG

Nov 21 1979 date well completed
Porter Drilling & Log firm name
Wayne county well located

LANDOWNER: Leon Martin
Pt 2 Heidelberg Miss

description of formations encountered	from	to
hard rock strata	0	20
clay	20	50
thin rock		50
clay	50	165
rock	165	168
clay	168	210
rock	210	212
clay	212	218
Heidelberg rock	218	240

(mailing address)

WELL LOCATION:
sec 32 T 10 N R 10 E S 1 W
3 miles W of Euacantha
(distance) (direction) (nearest town)

WELL PURPOSE: home
(home, irrigation, municipal, industrial)

- WELL COMPLETION DATA:
- (1) diameter (inches) 2"
 - (2) total depth (feet) 240
 - (3) static water level (feet) 127' below top of ground.
 - (4) casing steel 218' (material) (depth)
2" (size) If telescope see back.
 - (5) screen none used (length) (depth to top)
(size) (material)
 - (6) pump 2 (HP) 5 (yield gpm)
elec. (type power)
 - (7) electric log no (yes or no)
- (organization running log)

138' 1 1/4" galv. pipe

(8) how well bottom plugged open

DRILLERS REMARKS:


DEPT. OF NATURAL RESOURCES
BUREAU OF LAND & WATER RESOURCES

DEC 13 1979

RECEIVED

If well telescopes please sketch and show depths.

GROUND LEVEL

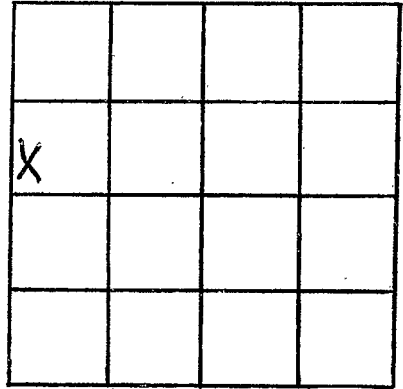

SECTION 32

Please indicate well location X.

ADDITIONAL INFORMATION

If more than one screen,
show locations of each on sketch.