

Wayne
A. [unclear]
1-8-80

MISSISSIPPI
BOARD OF WATER COMMISSIONERS
416 North State Street
Jackson, Mississippi 39201

WATER WELL DRILLERS LOG

1-8 1980 Roy U. West Drilling WAYNE
date well completed firm name county well located

LANDOWNER: VAN LOWREY	description of formations encountered	from	to
(mailing address)			
WELL LOCATION:	SAND	15'	85'
sec 22 T 10 N R 9 E S W			
4.5 miles NW of Eucutt			
(distance) (direction) (nearest town)			
WELL PURPOSE: HOME			
(home, irrigation, municipal, industrial)			
WELL COMPLETION DATA:			
(1) diameter (inches) 2"			
(2) total depth (feet) 85"			
(3) static water level (feet) 60' below top of ground.			
(4) casing PVC 80' (material) (depth)			
(size) If telescope see back.			
(5) screen 5' 80' (length) (depth to top)			
1/4" STAINLESS STEEL (size) (material)			
(6) pump 1 (HP) 6 (yield gpm)			
Electric (type power)			
(7) electric log NO (yes or no)			
(organization running log)			
(8) how well bottom plugged WASH VALVE			

DRILLERS REMARKS:


DEPT. OF NATURAL RESOURCES
BUREAU OF LAND & WATER RESOURCES

JAN 25 1980

RECEIVED

If well telescopes please sketch and show depths.

GROUND LEVEL

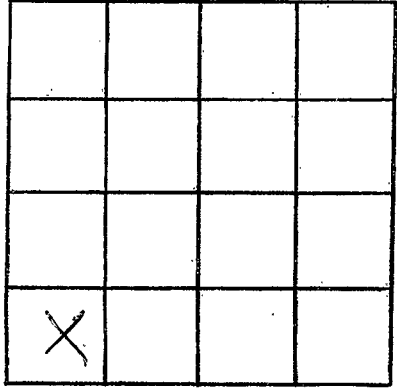

SECTION 22

Please indicate well location X.

ADDITIONAL INFORMATION

If more than one screen,
show locations of each on sketch.