

MISSISSIPPI DEPARTMENT OF NATURAL RESOURCES

Bureau of Land and Water Resources

Southport Mall

P.O. Box 10631

Jackson, Mississippi 39209

WATER WELL DRILLERS LOG

**WAYNE**  
 A 2007  
 9-3-80

Sept 3 1980 *Porter Drilling & Pipe* Wayne  
 date well completed firm name county well located

LANDOWNER: <u>Kam Lindsey</u>		description of formations encountered	from	to
<u>As 1</u>				
<u>Hubata Miss.</u>		<u>red clay</u>	<u>0</u>	<u>12</u>
(mailing address)		<u>blue clay</u>	<u>12</u>	<u>29</u>
WELL LOCATION:		<u>soil strata</u>	<u>29</u>	<u>70</u>
sec <u>26-10</u>	(N) <u>9</u> (E) <u>W</u>	<u>white clay</u>	<u>70</u>	<u>80</u>
miles <u>5.0</u> of <u>Excelsior</u>				
(distance)	(direction)	(nearest town)	<u>42' 1 1/4" galv. drop pipe</u>	
WELL PURPOSE: <u>Home</u> (home, irrigation, municipal, industrial)				
WELL COMPLETION DATA:				
(1) diameter (inches)	<u>2"</u>			
(2) total depth (feet)	<u>80</u>			
(3) static water level (feet)	<u>15</u> below top of ground.			
(4) casing (material)	<u>steel 51'</u>			
(depth)	<u>2'</u>			
If telescope see back.				
(5) screen (length)	<u>none used</u>			
(depth to top)				
(size)	(material)			
(6) pump (HP)	<u>1 10</u>			
(yield gpm)	<u>elec.</u>			
(type power)				
(7) electric log (yes or no)	<u>no</u>			
(organization running log)				
(8) how well bottom plugged	<u>open</u>			
DRILLERS REMARKS:				


DEPT. OF NATURAL RESOURCES  
 BUREAU OF LAND & WATER RESOURCES

SEP 24 1980

RECEIVED

If well telescopes please  
sketch and show depths.

GROUND LEVEL

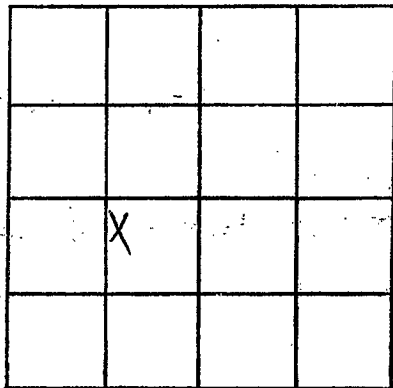

SECTION 26

Please indicate well location X.

ADDITIONAL INFORMATION

If more than one screen,  
show locations of each on sketch.