

MISSISSIPPI DEPARTMENT OF NATURAL RESOURCES

Bureau of Land and Water Resources

Southport Mall

P.O. Box 10631

Jackson, Mississippi 39209

WATER WELL DRILLERS LOG

WAYNE
A 2002
6-10-81

June 10 1981 date well completed
81 Boots Drilling, Inc. firm name
Wayne county well located

LANDOWNER: mae V.
L ofton
At 1 Shubuta Miss
(mailing address)

description of formations encountered	from	to
sand & clay	0	22
clay	22	32
fine blk sand & clay	32	68
thin rock		68
clay	68	119
Stuckberg	119	150


WELL LOCATION:
sec. 35 T 10 N S R 9 E W
1 1/2 miles S Shubuta
(distance) (direction) (nearest town)

84' 1 1/4" galv. pipe
drage

WELL PURPOSE: home
(home, irrigation, municipal, industrial)

- WELL COMPLETION DATA:
- (1) diameter (inches) 2"
 - (2) total depth (feet) 150
 - (3) static water level (feet) 65 (below/above top of ground)
 - (4) casing galv. 120' (material) (depth)
2" (size) if telescope see back.
 - (5) screen none used (length) (depth to top)
 - (6) pump 1 1/2 10 (HP) (yield gpm)
elec. (type power)
 - (7) electric log no (yes or no)
(organization running log)
 - (8) how well bottom plugged open

DRILLERS REMARKS:

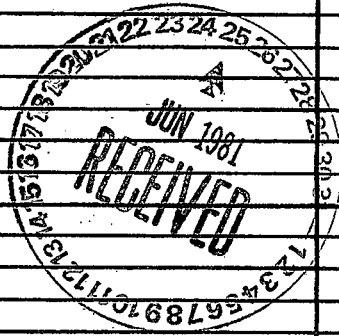

If well telescopes please sketch and show depths.

GROUND LEVEL



SECTION 35

Please indicate well location X.

ADDITIONAL INFORMATION

If more than one screen,
show locations of each on sketch.