

MISSISSIPPI DEPARTMENT OF NATURAL RESOURCES

Bureau of Land and Water Resources

Southport Mall

P.O. Box 10631

Jackson, Mississippi 39209

WATER WELL DRILLERS LOG

WAYNE  
A 2009  
11-11-81

Nov 11 1981 date well completed  
Bostra Drilling & Log firm name  
Stamps county well located

LANDOWNER: Davis Booz  
At 1 Shubuta  
Miss  
(mailing address)

description of formations encountered	from	to
<u>red clay</u>	<u>0</u>	<u>24</u>
<u>blue clay</u>	<u>24</u>	<u>33</u>
<u>rocky</u>	<u>33</u>	<u>36</u>
<u>clay</u>	<u>36</u>	<u>37</u>
<u>rock</u>	<u>37</u>	<u>38</u>
<u>clay</u>	<u>38</u>	<u>42</u>
<u>shaly clay</u>	<u>42</u>	<u>63</u>
<u>white clay &amp; rock</u>	<u>63</u>	<u>70</u>

WELL LOCATION:  
sec. 26 T. 10 N. R. 9 E. S. 1  
of Shubuta (nearest town)  
(distance) miles (direction)

WELL PURPOSE: shop & office  
(home, irrigation, municipal, industrial)

WELL COMPLETION DATA:

(1) diameter (inches) 4"

(2) total depth (feet) 75'

(3) static water level (feet) 12 (below/above top of ground)

(4) casing galv. steel (material) 43' (depth)  
4" (size) If telescope see back.

(5) screen none used (length) (depth to top)  
(size) (material)

(6) pump 1/2 sub (HP) 10 (yield gpm)  
elec. (type power)

(7) electric log no (yes or no)  
(organization running log)

(8) how well bottom plugged open


71' 1" galv. steel pipe

DRILLERS REMARKS:

DEPT. OF NATURAL RESOURCES  
BUREAU OF LAND & WATER RESOURCES  
NOV 25 1981  
RECEIVED

If well telescopes please sketch and show depths.

GROUND LEVEL

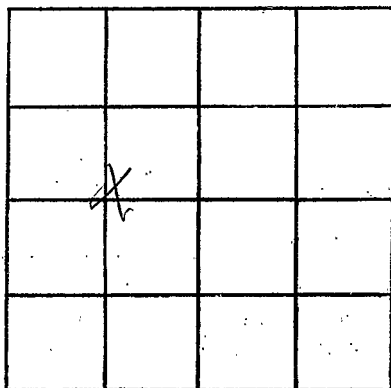

SECTION 26

Please indicate well location X.

ADDITIONAL INFORMATION

If more than one screen,  
show locations of each on sketch.