

Wayne
A2010

MISSISSIPPI
BOARD OF WATER COMMISSIONERS
416 North State Street
Jackson, Mississippi 39201

WATER WELL DRILLERS LOG

JAN 26 1984 Roy V. WEST DRLLG WAYNE
date well completed firm name county well located


LANDOWNER:	description of formations encountered	from	to
A. O. BAILES			
Shubatta Ms. (mailing address)	CLAY	1	14
	SAND	14	21
	GRAVEL	21	35
	CLAY	35	37
	SAND	37	96
WELL LOCATION: sec. 24 T. 10 N. R. 9 E S W			
2 miles N of Eucutt (distance) (direction) (nearest town)			
WELL PURPOSE: (home, irrigation, municipal, industrial)			
WELL COMPLETION DATA:			
(1) diameter (inches) 2"			
(2) total depth (feet) 96'			
(3) static water level (feet) 64' below top of ground.			
(4) casing PVC 91' (material) (depth)			
(size) if telescope see back.			
(5) screen 5' 91' (length) (depth to top)			
2" PVC (size) (material)			
(6) pump 1 6 (HP) (yield gpm)			
REA (type power)			
(7) electric log NO (yes or no)			
(organization running log)			
(8) how well bottom plugged WASH VALVE			
DRILLERS REMARKS:			

DEPT. OF NATURAL RESOURCES
BUREAU OF LAND & WATER RESOURCES

MAR 16 1984
RECEIVED

If well telescopes please sketch and show depths.

GROUND LEVEL

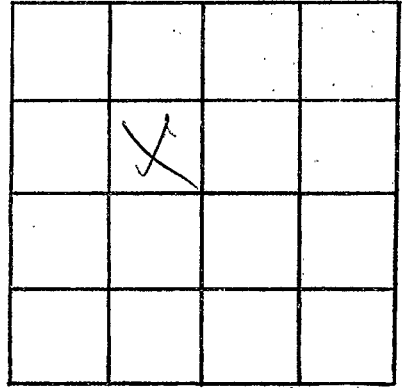

SECTION 24

Please indicate well location X.

ADDITIONAL INFORMATION

If more than one screen,
show locations of each on sketch.