

MISSISSIPPI DEPARTMENT OF NATURAL RESOURCES

Bureau of Land and Water Resources

P.O. Box 10631

Jackson, Mississippi 39209

WATER WELL DRILLERS LOG

COUNTY WELL LOCATED
Wayne

WELL NUMBER A	CODED
DATE WELL COMPLETED 2012 6-22-90	

PERMIT NUMBER

NAME OF DRILLING FIRM
Roy V. West

NAME & MAILING ADDRESS OF LANDOWNER
William White

Rt 1 Box 110

Shubuta MS 39360

WELL LOCATION: SEC **26** TOWNSHIP **10 N** RANGE **9 E**

DISTANCE **1.5** Miles DIRECTION **NW** of **Waynesboro**

OTHER LANDMARK

WELL PURPOSE: Home Irrigation, Municipal, Industrial, Fish Pond, etc.

PUMP DATA

PUMP TYPE (Circle One):
 Submersible, Turbine, Jet, Flowing Well,
Other (Describe) _____

POWER TYPE (Circle One):
Electric, Tractor, Diesel, Gasoline, Butane,
Other (Describe) _____ H/P **3**

Pump Capacity (GPM) 11	No. of Stages	Setting Depth 60' FT.
----------------------------------	---------------	---------------------------------

PUMP TEST

Well yielded _____ GPM with
a drawdown of _____ ft.
after _____ hours of pumping

WELL DATA

Well Depth 110'	Casing Diameter (In.) 4"	Casing Length (Ft.) 63'
Type of Casing PUC	Hole Depth 110'	Depth to Static Water Level 34'

TYPE OF COMPLETION: (Circle One or More):
 Gravel Packed, Underreamed, Telescoped,
 ~~None of Above~~, Open Hole, Other

Top of Lap Pipe or Reduction in Casing

FEET IF TELESCOPED OR MORE THAN ONE SCREEN: USE BACK PAGE

LOG DATA

TYPE OF LOG RUN (Circle One):
Electric, Gamma Ray, Density, Sonic, Neutron,
Other (Describe) _____

Name of Organization Running Log

SCREEN DATA

Diameter - Inches	Length - Feet	Slot Size - Inches
Screen Type	Depth to Bottom - Feet	

GEOLOGIC DATA (Office Use Only)

Surface Elev.	Geologic Unit	Unit Thickness	Depth to Top
Subs. SWL	Date	Analysis	Aquifer Test

Driller's Remarks

DESCRIPTION OF FORMATIONS ENCOUNTERED	FROM	TO
Red CLAY	0	21
CLAY	21	42
Limestone	42	110


FORMATIONS (Continued)

FORMATIONS (Continued)	FROM	TO
RECEIVED		
JUL 03 1990		
Department of Natural Resources		
Bureau of Land & Water Resources		

IF MORE SPACE IS NEEDED, USE BACK

If well telescopes please
sketch and show depths.

GROUND LEVEL

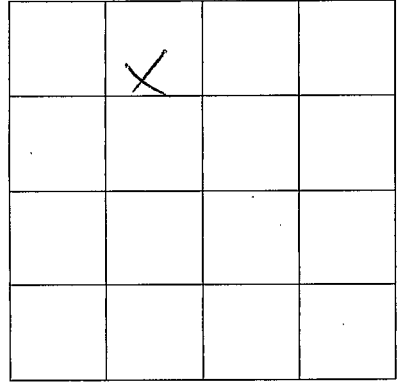

SECTION 26

Please indicate well location X.

ADDITIONAL INFORMATION

If more than one screen,
show location of each on sketch.