

**MISSISSIPPI DEPARTMENT OF ENVIRONMENTAL QUALITY**  
Bureau of Land and Water Resources

P. O. Box 10631  
Jackson, MS 39289-0631  
**WATER WELL DRILLERS LOG**

COUNTY WELL LOCATED <b>Wayne</b>	
WELL NUMBER <b>A</b>	CODED
DATE WELL COMPLETED <b>2014</b> <b>5-15-91</b>	

PERMIT NUMBER
NAME OF DRILLING FIRM <b>Roy U. West</b>

NAME & MAILING ADDRESS OF LANDOWNER <b>Gerald Donald</b>			
<b>P.O. Box 1945</b>			
<b>Laurel MS 39441</b>			
WELL LOCATION:	SEC	TOWNSHIP	RANGE
	<b>35</b>	<b>10<del>9</del></b>	<b><math>\frac{N}{S}</math> 9 <math>\frac{E}{W}</math></b>
DISTANCE	DIRECTION	NEAREST TOWN	
<b>1</b> Miles	<b>S</b>	of <b>Fucatta</b>	
OTHER LANDMARK			
WELL PURPOSE (Home) Irrigation, Municipal, Industrial, Fish Pond, etc.			

<b>PUMP DATA</b>		
PUMP TYPE (Circle One): <b>Submersible</b> Turbine, Jet Flowing Well, Other (Describe) _____		
POWER TYPE (Circle One): <b>Electric</b> Tractor, Diesel, Gasoline, Butane, Other (Describe) _____ H/P <b>3</b>		
Pump Capacity (GPM)	No. of Stages	Setting Depth
		<b>100'</b> FT.
PUMP TEST		
Well yielded _____ GPM with a drawdown of _____ ft. after _____ hours of pumping		

<b>WELL DATA</b>		
Well Depth <b>180'</b>	Casing Diameter (In.) <b>4"</b>	Casing Length (Ft.) <b>130'</b>
Type of Casing <b>PVC</b>	Hole Depth <b>180'</b>	Depth to Static Water Level <b>70'</b>
TYPE OF COMPLETION: (Circle One or More): Gravel Packed, Underreamed, Telescoped, Natural Development, <b>Open Hole</b> , Other		
Top of Lap Pipe or Reduction in Casing		
FEET		
IF TELESCOPED OR MORE THAN ONE SCREEN: USE BACK PAGE		

<b>LOG DATA</b>	
TYPE OF LOG RUN (Circle One): Electric, Gamma Ray, Density, Sonic, <b>No Log Run</b> , Neutron, Other (Describe) _____	
Name of Organization Running Log	

<b>SCREEN DATA</b>		
Diameter - Inches	Length - Feet	Slot Size - Inches
Screen Type	Depth to Bottom - Feet	

<b>GEOLOGIC DATA (Office Use Only)</b>			
Surface Elev.	Geologic Unit	Unit Thickness	Depth to Top
Subs. SWL	Date	Analysis	Aquifer Test
Driller's Remarks			


DESCRIPTION OF FORMATIONS ENCOUNTERED	FROM	TO	FORMATIONS (Continued)	FROM	TO
<b>SANDY CLAY</b>	<b>0</b>	<b>32</b>	<b>RECEIVED</b> <b>JUL 15 1991</b>		
<b>SILTY SAND</b>	<b>32</b>	<b>61</b>			
<b>CLAY</b>	<b>61</b>	<b>126</b>			
<b>Limestone</b>	<b>126</b>	<b>145</b>			
<b>Limestone &amp; CLAY</b>	<b>145</b>	<b>180</b>			

IF MORE SPACE IS NEEDED, USE BACK

Dept. of Environmental Quality  
Bureau of Land & Water Resources

If well telescopes please  
sketch and show depths.

GROUND LEVEL

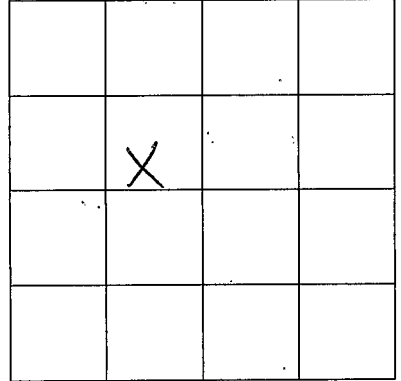

SECTION 35

Please indicate well location X.

ADDITIONAL INFORMATION

If more than one screen,  
show location of each on sketch.