

B4

9-24-63

WATER WELL DRILLERS LOG

Date: Sept 24, 1963, Driller: Borland Drilling & Pump Co. Wayne
(Name)

(1) Owner of Land: Ralph Walker
(Name)
Rt 1 Shubuta
(Address)

(2) Location: SE 1/4, SE 1/4, Sec. 35 T10R8,
10 miles NW, of Waynesboro
(distance) (direction) (Nearest Town)

(3) Topography: hilly
(Hilly) (Flat) (Level)

(4) Purpose of Well: domestic
(Domestic Irrigation Municipal, Industrial, Other)

Description & Color of Materials Sand, Clay, Red Clay, Shell, etc.	Thick- ness Feet	Depth Feet
<u>red clay</u>	<u>9</u>	<u>9</u>
<u>chalk</u>	<u>6</u>	<u>15</u>
<u>red sand</u>	<u>12</u>	<u>27</u>
<u>fine yellow sand</u>	<u>12</u>	<u>39</u>
<u>sand & chalk</u>	<u>6</u>	<u>45</u>
<u>sand & pea gravel</u>	<u>15</u>	<u>60</u>
<u>sand</u>	<u>69</u>	<u>129</u>
<u>yellow sand</u>	<u>3</u>	<u>132</u>
<u>stopped on rock</u>		

Information upon completion of well:

(1) Diameter 2" inches.

(2) Total Depth 129' feet.

(3) Water Level 92' feet below top of ground.


(4) Cased to 126', Size 2"

(5) Screen: Size 1 1/4", Length 3'

(6) Were any formations sealed against pollution?
Johnson S.S.
 yes, no.

If YES depth of formation _____
 Why _____

Drillers Remarks: _____

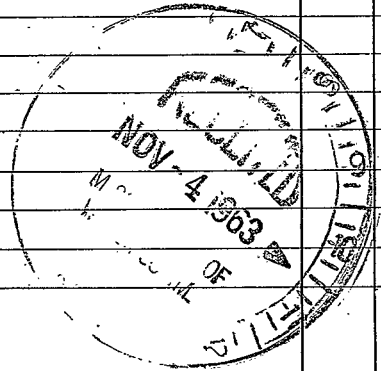

(Use Back Side)

Well No. _____

