

Wayne
B8
10-66

MISSISSIPPI BOARD OF WATER COMMISSIONERS

4 P

WATER WELL DRILLERS LOG

Date: 10-6, 1966, Driller: E. L. Stringer County Wayne
 (When well drilled) (Name) (Where well is located)

(1) Owner of Land: Mrs. Ford Reeves
 (Name)

(2) Location: 330' N + 370' W of SE cor SEC 21-10N-8W
 (Address)
1/4, 1/4, Sec. T. R.
 (distance) (direction) (Nearest Town)

(3) Topography: Hilly
 (Hilly) (Flat) (Level)

(4) Purpose of Well: Industrial
 (Domestic Irrigation
 Municipal, Industrial, Other)

Description & Color of Materials Sand, Clay, Red Clay, Shell, etc.	Thick- ness Feet	Depth Feet
<u>Green clay</u>	<u>16</u>	<u>16</u>
<u>W cavity</u>	<u>2</u>	<u>18</u>
<u>sand + solid rock</u>	<u>7</u>	<u>25</u>
<u>W cavity</u>	<u>2</u>	<u>27</u>
<u>sand</u>	<u>13</u>	<u>40</u>
<u>clay + solid rock</u>	<u>40</u>	<u>80</u>
<u>Stratified sand + shale</u>	<u>46</u>	<u>126</u>
<u>Stratified sand + shale</u>	<u>229</u>	<u>355</u>
<u>solid sand</u>	<u>64</u>	<u>419</u>

Information upon completion of well:

(1) Diameter 6 inches.

(2) Total Depth 419 feet.

(3) Water Level _____ feet below top of ground.

(4) Cased to 419, Size 3''

SLOTTED PIPE

(5) Screen: Size _____, Length 20

(6) Were any formations sealed against pollution?
 _____ yes, ✓ no.

If YES depth of formation _____

Why _____


Drillers Remarks: _____

Yield in gpm: 70

Size pump: oil compressor

Type power: _____

Lost circulation at 16' + it was never regained

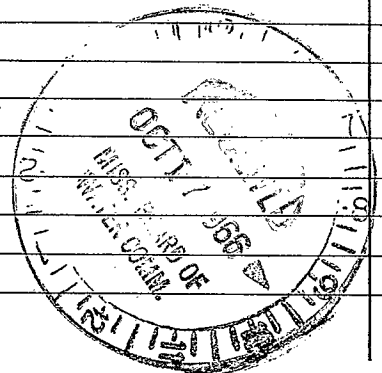

Mail this copy to Board of Water Commissioners 429 Miss. St. Jackson, Miss.

1888

1889

1890

1891

1892

1893

1894

1895

1896

1897

1898

1899