

3 P

Wayne
B9
7-67

MISSISSIPPI
BOARD OF WATER COMMISSIONERS
416 North State Street
Jackson, Mississippi 39201

WATER WELL DRILLERS LOG

July 21 1967 Porter Drilling & Log Wayne
date well completed firm name county well located


LANDOWNER: Oscar D. Barnett
At 1 Shubuta Miss
(mailing address)

WELL LOCATION:
sec. 33 T. 10 N. R. 8 E. S. W
10 miles NW of Waynesboro
(distance) (direction) (nearest town)

WELL PURPOSE: home
(home, irrigation, municipal, industrial)

- WELL COMPLETION DATA:
- (1) diameter (inches) 2"
 - (2) total depth (feet) 221'
 - (3) static water level (feet) 150 below top of ground.
 - (4) casing steel, 197' (material) (depth)
2" (size) if telescope see back.
 - (5) screen none, (length) (depth to top)
(size) (material)
 - (6) pump 2 4 (HP) (yield gpm)
elec (type power)
 - (7) electric log _____ (yes or no)
(organization running log)
 - (8) how well bottom plugged open

description of formations encountered	from	to
red clay	0	14
sand	14	80
sand to pea gravel	80	118
red chalk to gravel	118	122
red chalk	122	126
blue chalk	126	139
rock strata	139	152
blue chalk	152	197
Vicksburg honeycomb		
shale	197	221

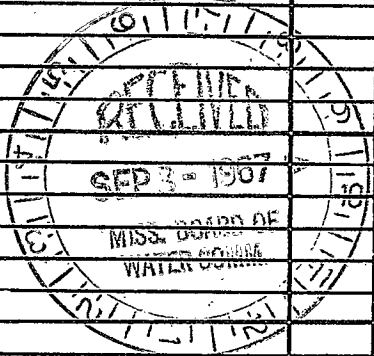

DRILLERS REMARKS:

If well telescopes please sketch and show depths.

GROUND LEVEL

			X

SECTION 33

Please indicate well location X.

ADDITIONAL INFORMATION

If more than one screen,
show locations of each on sketch.