

Wayne  
 B11  
 10-26-68

MISSISSIPPI  
 BOARD OF WATER COMMISSIONERS  
 416 North State Street  
 Jackson, Mississippi 39201

CODED

WATER WELL DRILLERS LOG

Oct 24 1968 Porter Drilling & Log Wayne  
 date well completed firm name county well located

LANDOWNER: Mrs. M. J. Waller  
 Waller  
 Rt 1, Shalonda  
 (mailing address)

description of formations encountered	from	to
well clean	0	10
fine sand	10	48
course sand	48	92
sand & chert	92	107
fine mud sand	107	126
" " mud fine sand	126	140
stopper white shell in sand		

WELL LOCATION:  
 sec. 35 T 10 N R 8 E  
 S W  
 10 miles NW of Waynesboro  
 (distance) (direction) (nearest town)

WELL PURPOSE: home  
 (home, irrigation, municipal, industrial)

WELL COMPLETION DATA:

(1) diameter (inches) 2"  
 (2) total depth (feet) 140'  
 (3) static water level (feet) 118' below top of ground.  
 (4) casing steel, 126'  
 (material) (depth)  
 2" If telescope see back.  
 (size)  
 (5) screen 5', 135'  
 (length) (depth to top)  
 1/4" basket, S.S.  
 (size) (material)  
 (6) pump 3/4 HP, 3 1/2  
 (HP) (yield gpm)  
 elec  
 (type power)  
 (7) electric log none  
 (yes or no)  
 (organization running log)  
 (8) how well bottom plugged -  
 packed cement

CODED


NOV 7 1968

MISS. Bd. of  
 WATER COMMISSIONERS

DRILLERS REMARKS:

If well telescopes please sketch and show depths.

GROUND LEVEL

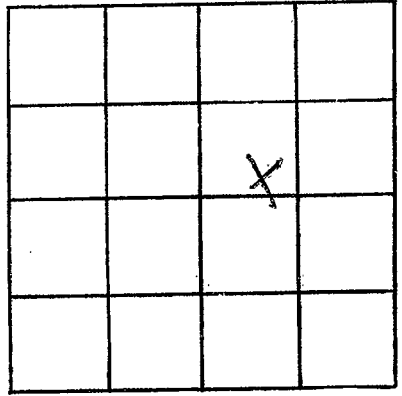

SECTION 35

Please indicate well location X.

ADDITIONAL INFORMATION

If more than one screen, show locations of each on sketch.