

Wayne
B 13
2-17-70

MISSISSIPPI
BOARD OF WATER COMMISSIONERS
416 North State Street
Jackson, Mississippi 39201

CODED

WATER WELL DRILLERS LOG

Feb. 17 1970 Doyle Drilling Co. Wayne
date well completed firm name county well located


LANDOWNER: <u>Benny Walker</u>	description of formations encountered	from	to
<u>211 Shubuta Miss</u> (mailing address)	<u>red clay</u> <u>orange sand & open gravel</u> <u>red line sand</u> <u>stagnant water</u> <u>shell in sand</u>	<u>0</u>	<u>8</u> <u>85</u> <u>101</u>
WELL LOCATION: sec <u>35</u> T <u>10</u> S R <u>8</u> E <u>8</u> miles <u>NW</u> of <u>Waynesboro</u> (distance) (direction) (nearest town)	<u>5' 1/2" 7' 1/2" 5' 1/2" 2' 1/2"</u>		<u>with</u>
WELL PURPOSE: <u>Home</u> (home, irrigation, municipal, industrial)	<u>2' 1/2" log hole in</u>		
WELL COMPLETION DATA: (1) diameter (inches) <u>2"</u> (2) total depth (feet) <u>101'</u> (3) static water level (feet) <u>79</u> ^{below} / _{above} top of ground. (4) casing <u>steel</u> <u>95'</u> (material) (depth) <u>2"</u> if telescope see back. (size) (5) screen <u>5'</u> <u>96'</u> (length) (depth to top) <u>1/4"</u> <u>7' 1/2" S.S.</u> (size) (material) (6) pump <u>1/2 rod</u> <u>3 1/2</u> (HP) (yield gpm) <u>elec</u> (type power) (7) electric log <u>no</u> (yes or no) <u>(organization running log)</u>	<u>with cylinder</u>		
(8) how well bottom plugged <u>flush point</u> DRILLERS REMARKS:			

FFR 24 1970

MISS. BD. OF
WATER COMMISSIONERS

If well telescopes please sketch and show depths.

GROUND LEVEL

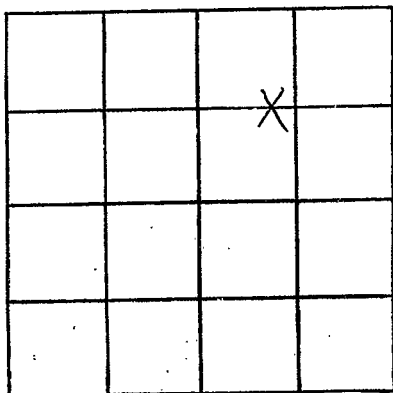

SECTION 35

Please indicate well location X.

ADDITIONAL INFORMATION

If more than one screen,
show locations of each on sketch.