

WAYNE
B14
2-15-71

MISSISSIPPI
BOARD OF WATER COMMISSIONERS
416 North State Street
Jackson, Mississippi 39201

CODED

WATER WELL DRILLERS LOG

Feb 15 1971 Roy West Water Wells Wayne
date well completed firm name county well located

LANDOWNER: Mattie Graham
Rt 1
Shubetta Miss
(mailing address)

Description of formations encountered	from	to
Clay	0	5
Sandy Clay	5	25
Sand	25	58
Blue clay	58	98
Rockwood Clay	98	153
Clay	153	175

WELL LOCATION:
sec. 3/T-10 N R. 8 E
10 miles S of Shubetta
(distance) (direction) (nearest town)

WELL PURPOSE: home
(home, irrigation, municipal, industrial)

- WELL COMPLETION DATA:
- (1) diameter (inches) 2
 - (2) total depth (feet) 175
 - (3) static water level (feet) 112 below above top of ground.
 - (4) casing Galv 147
(material) (depth)
 - (size) If telescope see back.
 - (5) screen None
(length) (depth to top)
 - (size) (material)
 - (6) pump 1hp 5
(HP) (yield gpm)
 - REA
(type power)
 - (7) electric log No
(yes or no)
 - (organization running log)
 - (8) how well bottom plugged wash water

CODED


FEB 25 1971

DRILLERS REMARKS:

MISS. BD. OF
WATER COMM.

If well telescopes please sketch and show depths.

GROUND LEVEL

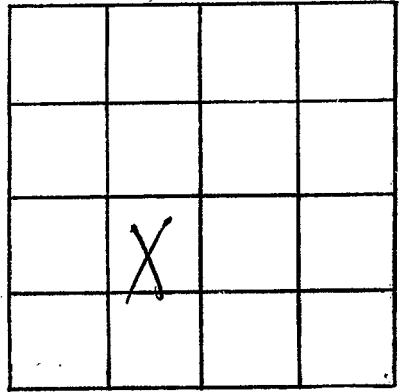

SECTION 31

Please indicate well location X.

ADDITIONAL INFORMATION

If more than one screen, show locations of each on sketch.