

WAYNE MISSISSIPPI BOARD OF WATER COMMISSIONERS

815
5-2-62

WATER WELL DRILLERS LOG

CODED

Date: 5/2, 1962, Driller: C. P. Clark County Wayne
471 18
(Name)

- (1) Owner of Land: ALEC Dale (Name)
Rt # 1 Shubuta Miss (Address)
- (2) Location: 1/4, 1/4, Sec. 26 T10 R 8,
5 miles East of Shubuta
(distance) (direction) (Nearest Town)
- (3) Topography: (Hilly) (Flat) (Level)
- (4) Purpose of Well: Domestic Irrigation
 Municipal, Industrial, Other


Description & Color of Materials Sand, Clay, Red Clay, Shell, etc.	Thick- ness Feet	Depth Feet
0-10 Sandy Clay	10	
10-50 Yellow Sand	40	
50-86 White Sand	36	

Information upon completion of well:

- (1) Diameter 2 inches.
- (2) Total Depth 86 feet.
- (3) Water Level 44 feet below top of ground.
- (4) Cased to 80, Size 2
- (5) Screen: Size 1 1/4, Length 6
- (6) Were any formations sealed against pollution?
no.

If YES depth of formation _____
Why _____
Drillers Remarks: _____

CODED

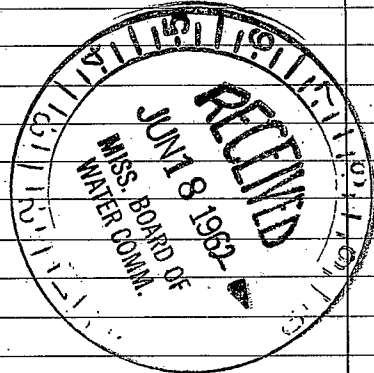

(Use Back Side)

Well No.

Mail