

WAYNE
B 16
5-18-71

MISSISSIPPI
BOARD OF WATER COMMISSIONERS
416 North State Street
Jackson, Mississippi 39201

CODED

WATER WELL DRILLERS LOG

May 18 1971 Paul D. Miller & Son Name
date well completed firm name county well located


LANDOWNER <u>Paul D. Miller</u>	description of formations encountered	from	to
<u>At 1 Shibuta Miss</u> (mailing address)	<u>clay & chert</u> <u>lime sand & chert</u> <u>low coarse clean</u>	<u>0</u>	<u>30</u> <u>124</u>
WELL LOCATION: sec <u>35</u> T <u>10</u> N R <u>8</u> E <u>9</u> miles <u>NW</u> of <u>Stamwood</u> (distance) (direction) (nearest town)	<u>white sand</u> <u>shaly white</u> <u>still in good sand</u>	<u>124</u>	<u>131</u>
WELL PURPOSE: <u>domestic</u> (home, irrigation, municipal, industrial)	<u>5' 1/4" total S.S.</u>		
WELL COMPLETION DATA:	<u>well 9' 1/4" deep</u>		
(1) diameter (inches) <u>2"</u>	<u>pipe section well</u>		
(2) total depth (feet) <u>7.31'</u>	<u>packer</u>		
(3) static water level (feet) <u>29</u> (below/above top of ground)	<u>105' 1/4" drop pipe</u>		
(4) casing <u>steel</u> <u>118'</u> (material) (depth)			
<u>2"</u> if telescope see back. (size)			
(5) screen <u>5'</u> <u>126'</u> (length) (depth to top)			
<u>1 1/2"</u> <u>7 salt SS.</u> (size) (material)			
(6) pump <u>1 1/2</u> <u>8 1/2</u> (HP) (yield gpm)			
<u>elec</u> (type power)			
(7) electric log <u>no</u> (yes or no)			
(organization running log)			
(8) how well bottom plugged <u>flush cement</u>			
DRILLERS REMARKS:			

CODED

MAY 1 1971

If well telescopes please sketch and show depths.

GROUND LEVEL

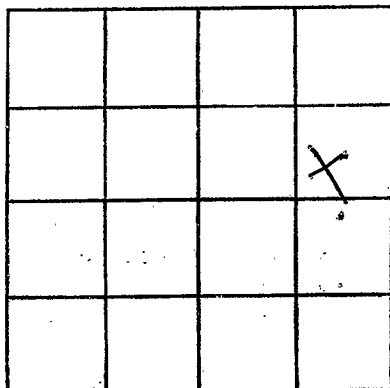

SECTION 35

Please indicate well location X.

ADDITIONAL INFORMATION

If more than one screen, show locations of each on sketch.