

BOARD OF WATER COMMISSIONERS

416 North State Street

Jackson, Mississippi 39201



WAYNE

B17

10-16-72

WATER WELL DRILLERS LOG

Oct 6 1972 date well completed
Pete Dillingham firm name
Wayne county well located

LANDOWNER: Robert Barnett

description of formations encountered

from to

211 Shubuta Miss (mailing address)

1st clay 0 20
sand 20 113
shaly sand sub

WELL LOCATION:

sec 34 T 10 N S R 2 E W
11 miles NW of Magnolia (distance) (direction) (nearest town)

WELL PURPOSE: Aerial (home, irrigation, municipal, industrial)

105' 1 1/2" long pipe

WELL COMPLETION DATA:

- (1) diameter (inches) 2
- (2) total depth (feet) 113'
- (3) static water level (feet) 26 below top of ground
- (4) casing steel 109' (material) (depth)
2" if telescope see back. (size)
- (5) screen 5' 109' (length) (depth to top)
1/2" 20 mesh S.S. (size) (material)
- (6) pump 1 1/2 (HP) 1.0 (yield gpm)
elec (type power)
- (7) electric log no (yes or no)

1 1/2" 20 mesh S.S. casing

(organization running log)

OCT 19 1972


(8) how well bottom plugged
shaly sand

DRILLERS REMARKS:

MISSISSIPPI BOARD OF WATER COMMISSIONERS

If well telescopes please sketch and show depths.

GROUND LEVEL

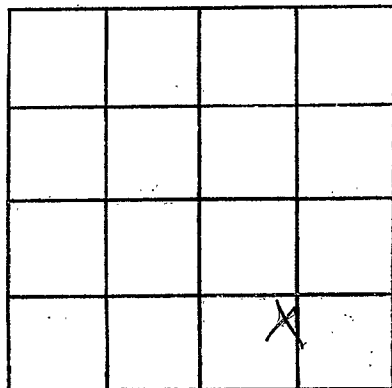

SECTION 34

Please indicate well location X.

ADDITIONAL INFORMATION

If more than one screen,
show locations of each on sketch.